


T.2S.R.39E.W.M.

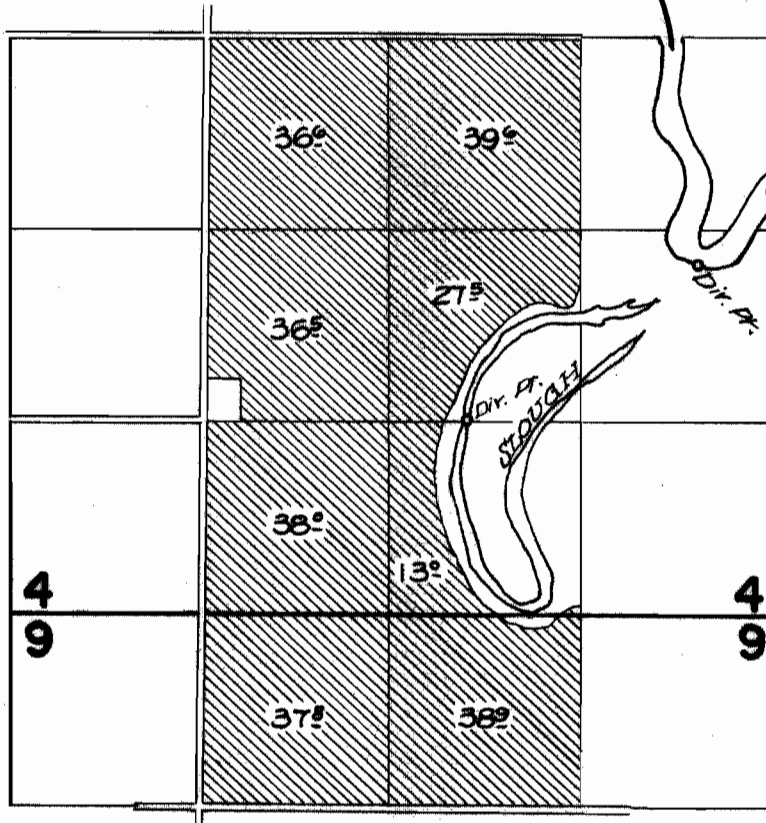

FINAL PROOF SURVEY
UNDER

Application No. 35046. Permit No. 27541
IN NAME OF

MONICA KINNEL DEEDS

Surveyed Oct. 3, 1963, by T. Lauer

RL