


# T. IS. R. 39 E. W. M.

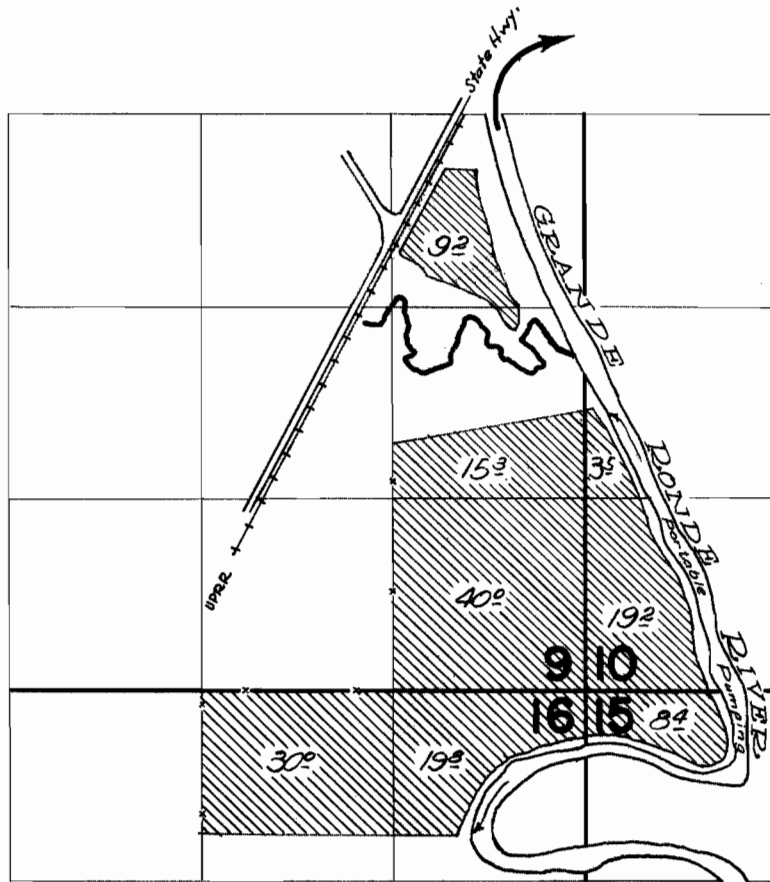

## FINAL PROOF SURVEY UNDER

Application No. 38205... Permit No. 28468...  
IN NAME OF

LEON R. JACKSON

Surveyed Sept. 24 1963, by T. Lauer