


T.1S.R.38E.W.M.

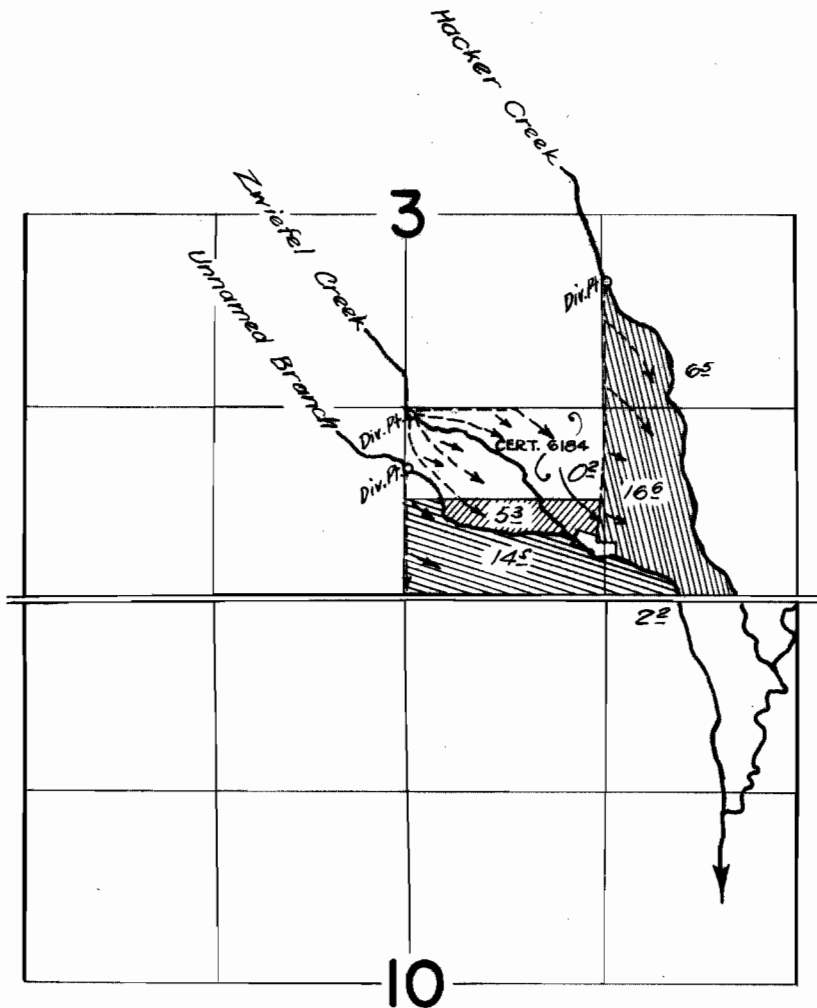

FINAL PROOF SURVEY
UNDER

Application No. **38450** Permit No. **28637**
IN NAME OF

CARL C. & HAZEL N. CLARK

Surveyed Sept. 30 1903, by T. Lauer

Rf