


T. IS. R. 38 E. W. M.

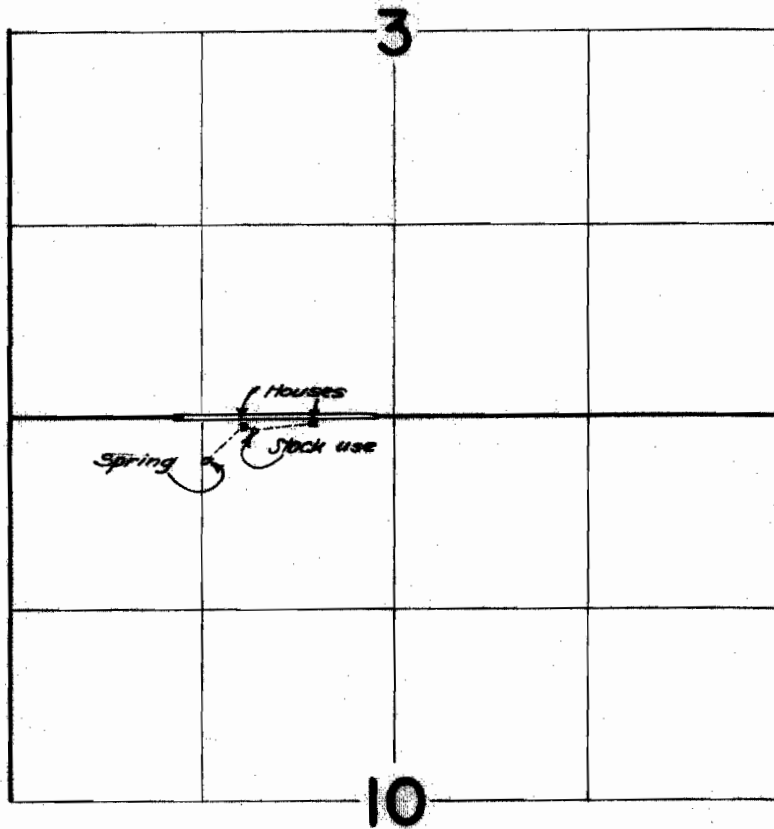

FINAL PROOF SURVEY
UNDER

Application No. 38723 Permit No. 28833...
IN NAME OF

WAYNE R. FRIZZELL AND ERNEST R. PUGH

Surveyed Sept. 30 1963, by T. Lauer