


G-233
G-620

T. 1 N. R. 13 E. W. M.

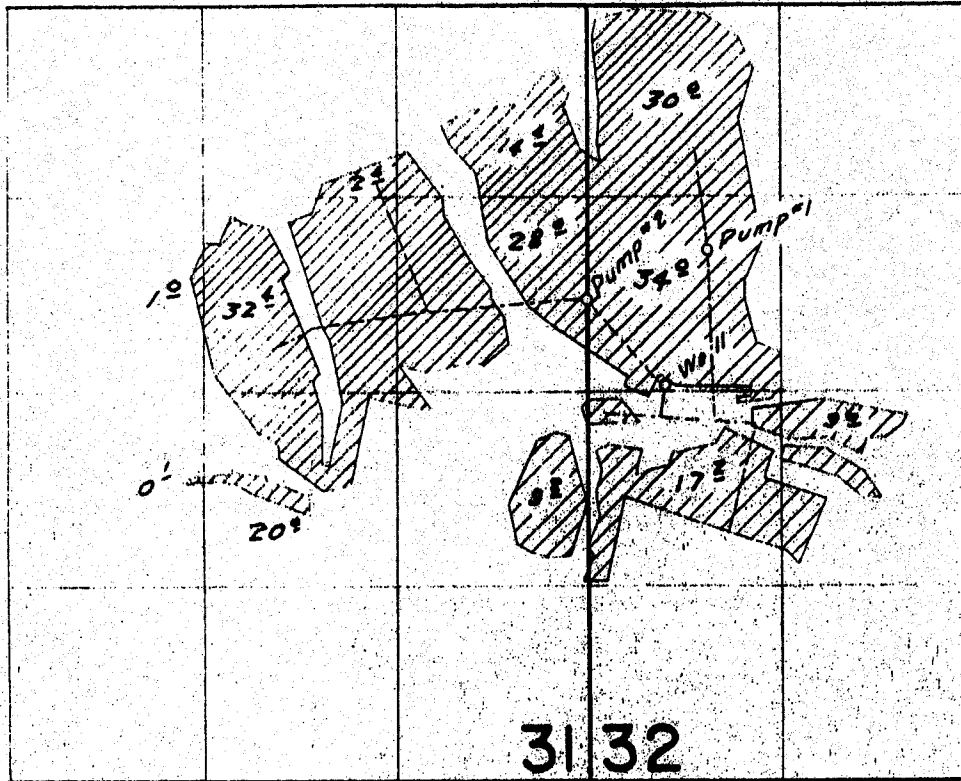

FINAL PROOF SURVEY UNDER

G-161 G-233
Application No. G-712 Permit No. G-620
IN NAME OF

S. A., CECYL, JOHN H. & BETTY JANE SKIRVING

Surveyed Oct. 27, 28 1964, by C. J. Gardner