


G-233  
G-620

# T.1N. R.13E.W.M.

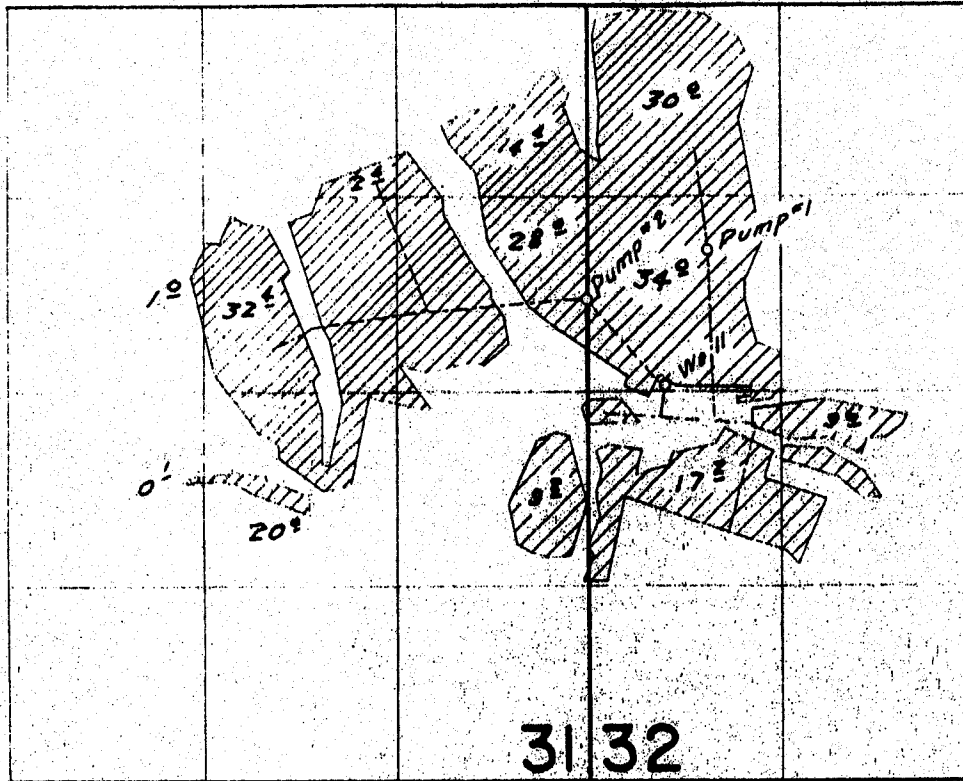

## FINAL PROOF SURVEY UNDER

G-161                      G-233  
Application No. 9-712    Permit No. G-620  
IN NAME OF

**S. A., CECYL, JOHN H. & BETTY JANE SKIRVING**

Surveyed Oct. 27, 28 1964, by *C. J. Gardner*