


T.2N.R.14&15E.W.M.

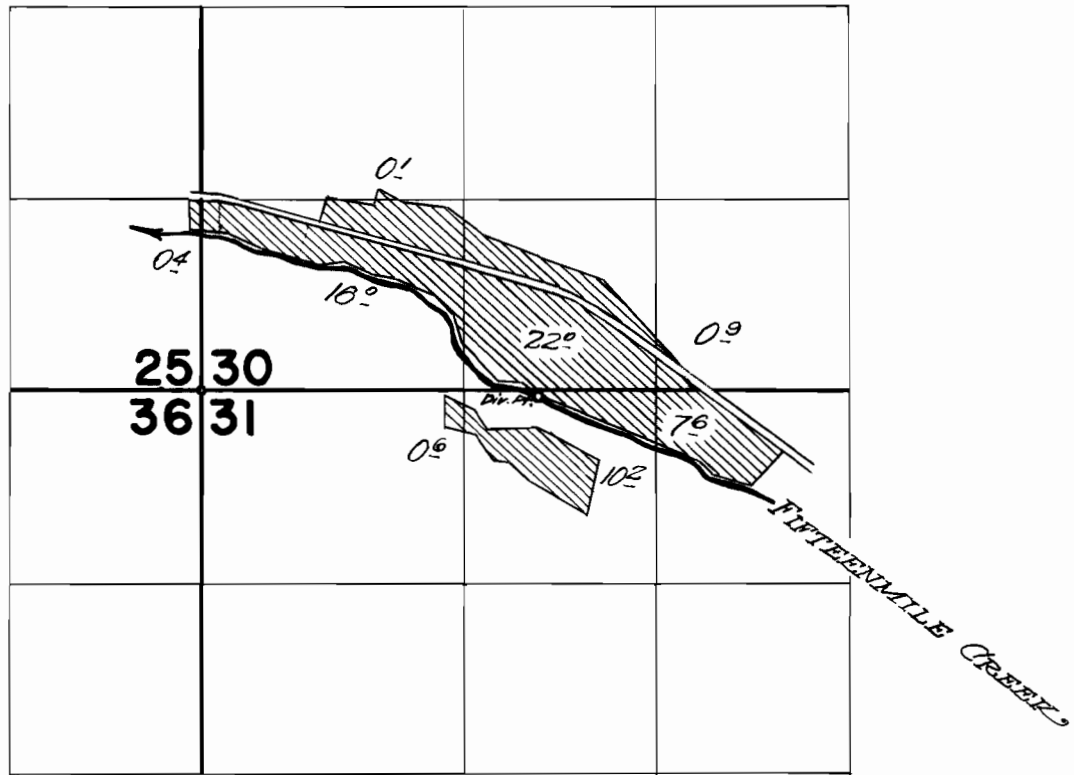

**FINAL PROOF SURVEY**  
UNDER

Application No. 33876... Permit No. 26700...  
IN NAME OF

CLARENCE E. QUIRK

Surveyed Oct. 30 1963, by C. Baker