


27210

T. 2 N. R. 15 E. W.M.

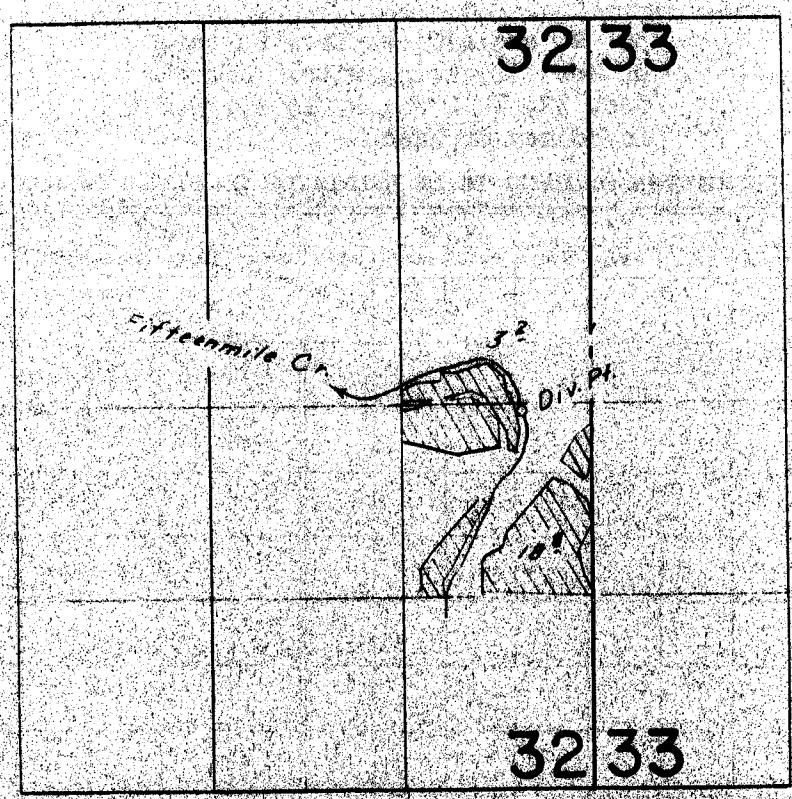

FINAL PROOF SURVEY UNDER

Application No. 34640 Permit No. 27210
IN NAME OF

GEORGE PETROFF

Surveyed Oct. 30, 1964, by *C.V. Gardner*