


T. 5 S. R. 5 W. W. M.

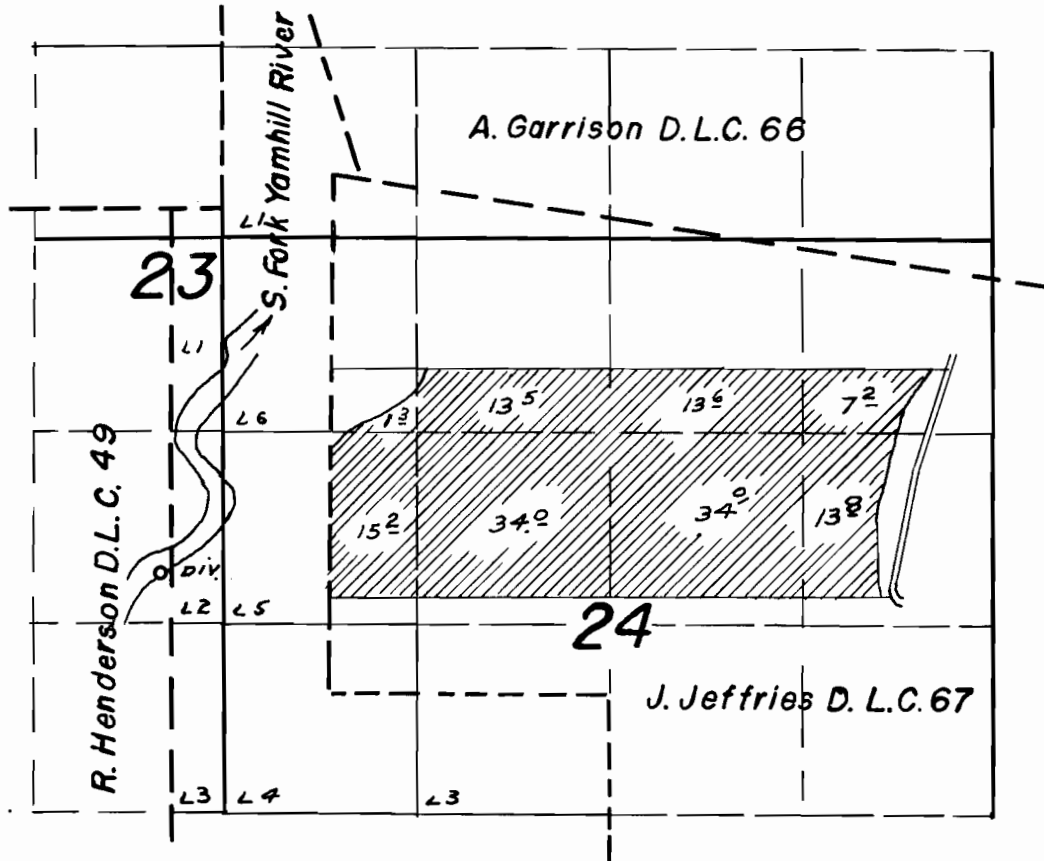

FINAL PROOF SURVEY
UNDER

Application No. 37262 Permit No. 27760
IN NAME OF

Herman E. Wood

Surveyed Aug. 7 1964, by R. Jackson