


T. 11 S. R. 1 E. W. M.

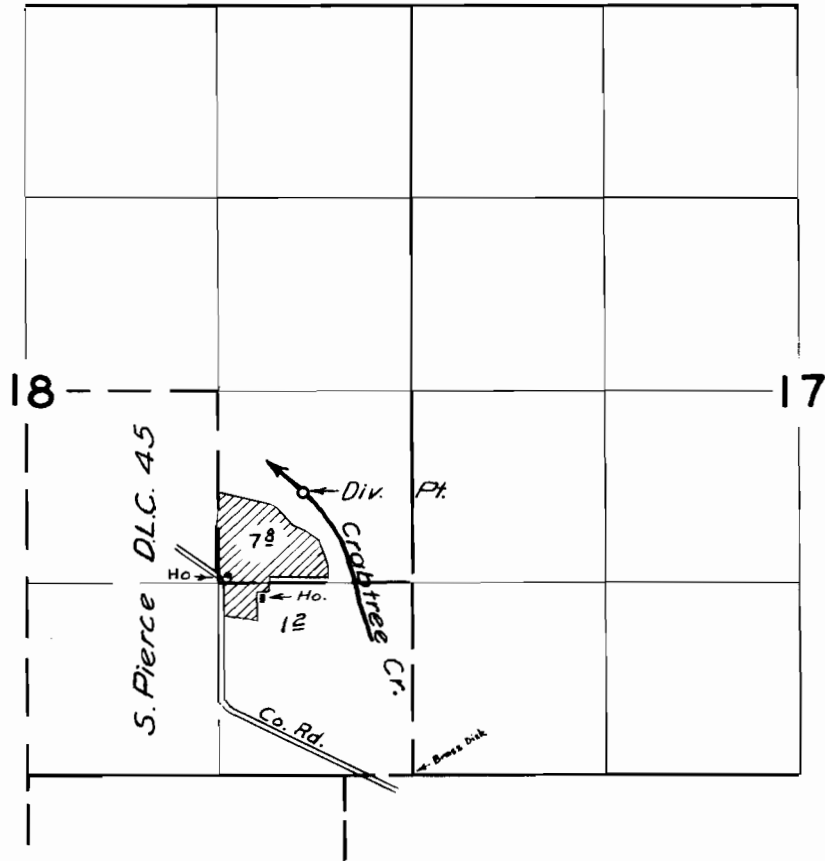

FINAL PROOF SURVEY UNDER

Application No. 20131 Permit No. 20584
IN NAME OF

Creta F. Moran

Surveyed July 10, 1957, by M. Bish