


T.10S.R.30E.W.M.

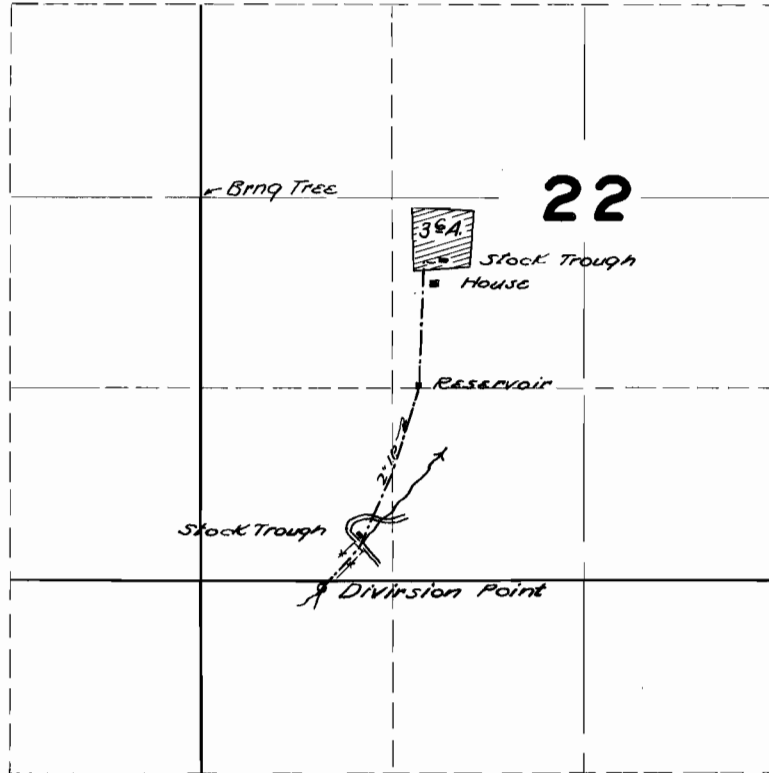

FINAL PROOF SURVEY UNDER

Application No. **18694** Permit No. **14377**
IN NAME OF

JOHN L. CARTER

Surveyed **NOV. 2, 1949**, by **H.L. COFFMAN**.