


T. 4S. R. 1E. W.M.

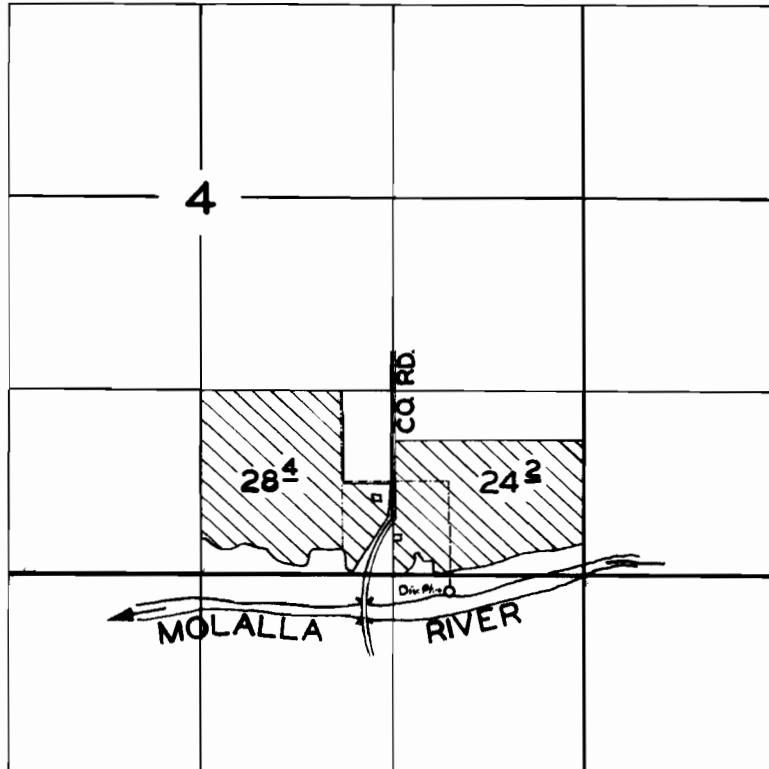

**FINAL PROOF SURVEY**  
UNDER

Application No. 26773 Permit No. 20937  
IN NAME OF

**OWEN DALEN & ALFRED CHRISTENSON**

Surveyed 23 MAR 1956, by R. D. BEST