


T. 30S. R. 4W.W.M.

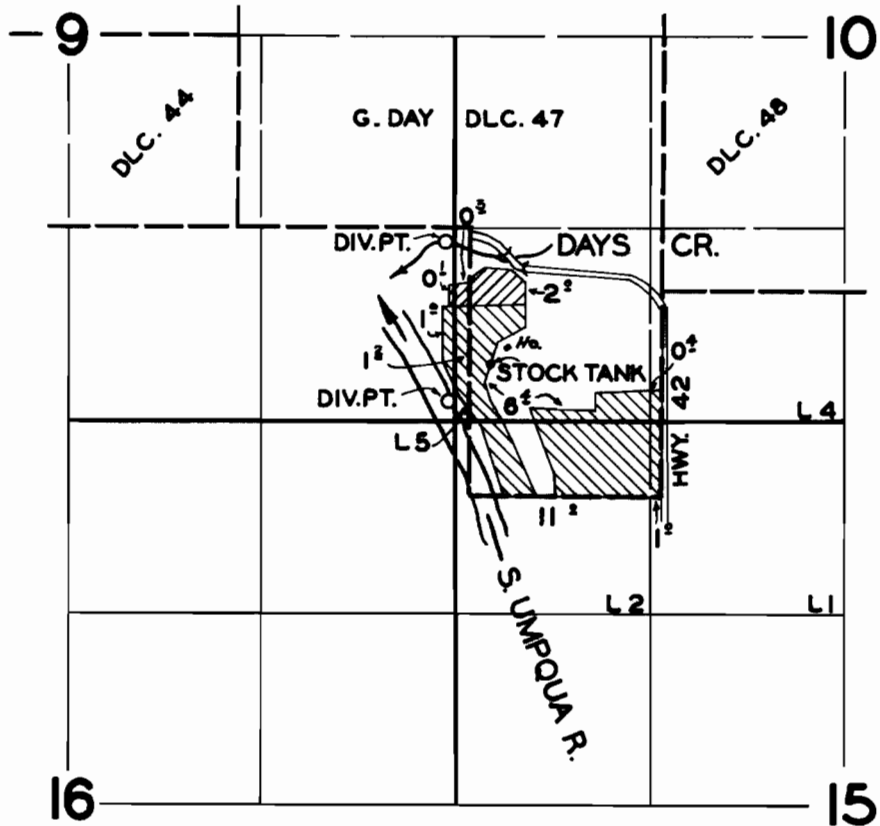

**FINAL PROOF SURVEY**  
UNDER

Application No. 22247. Permit No. 17547.  
IN NAME OF

**ALBERT M. ROWE**

Surveyed JULY 27, 1957, by *M. Bish*