


T.39 S.R.10 E.W.M.

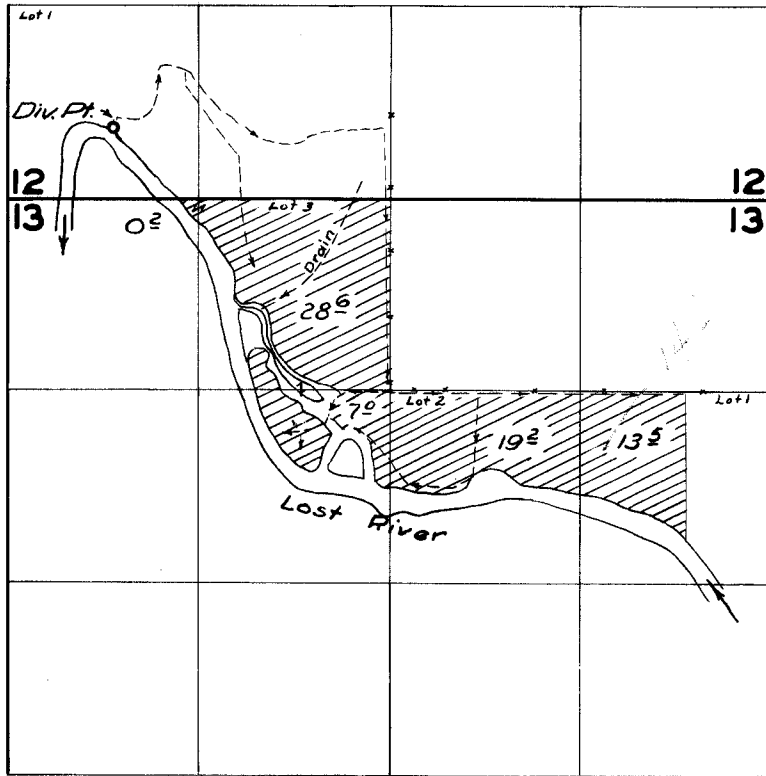

10°

FINAL PROOF SURVEY

UNDER

TRANSFER NO. S-96

APPLICANT GEORGE E. STEVENSON

IN ACQUITTANCE

BY GEO. E. STEVENSON

SURVEYED OCT. 24 1859 BY T. BISHOP