


T. 36 S., R. 2 W., W. M.

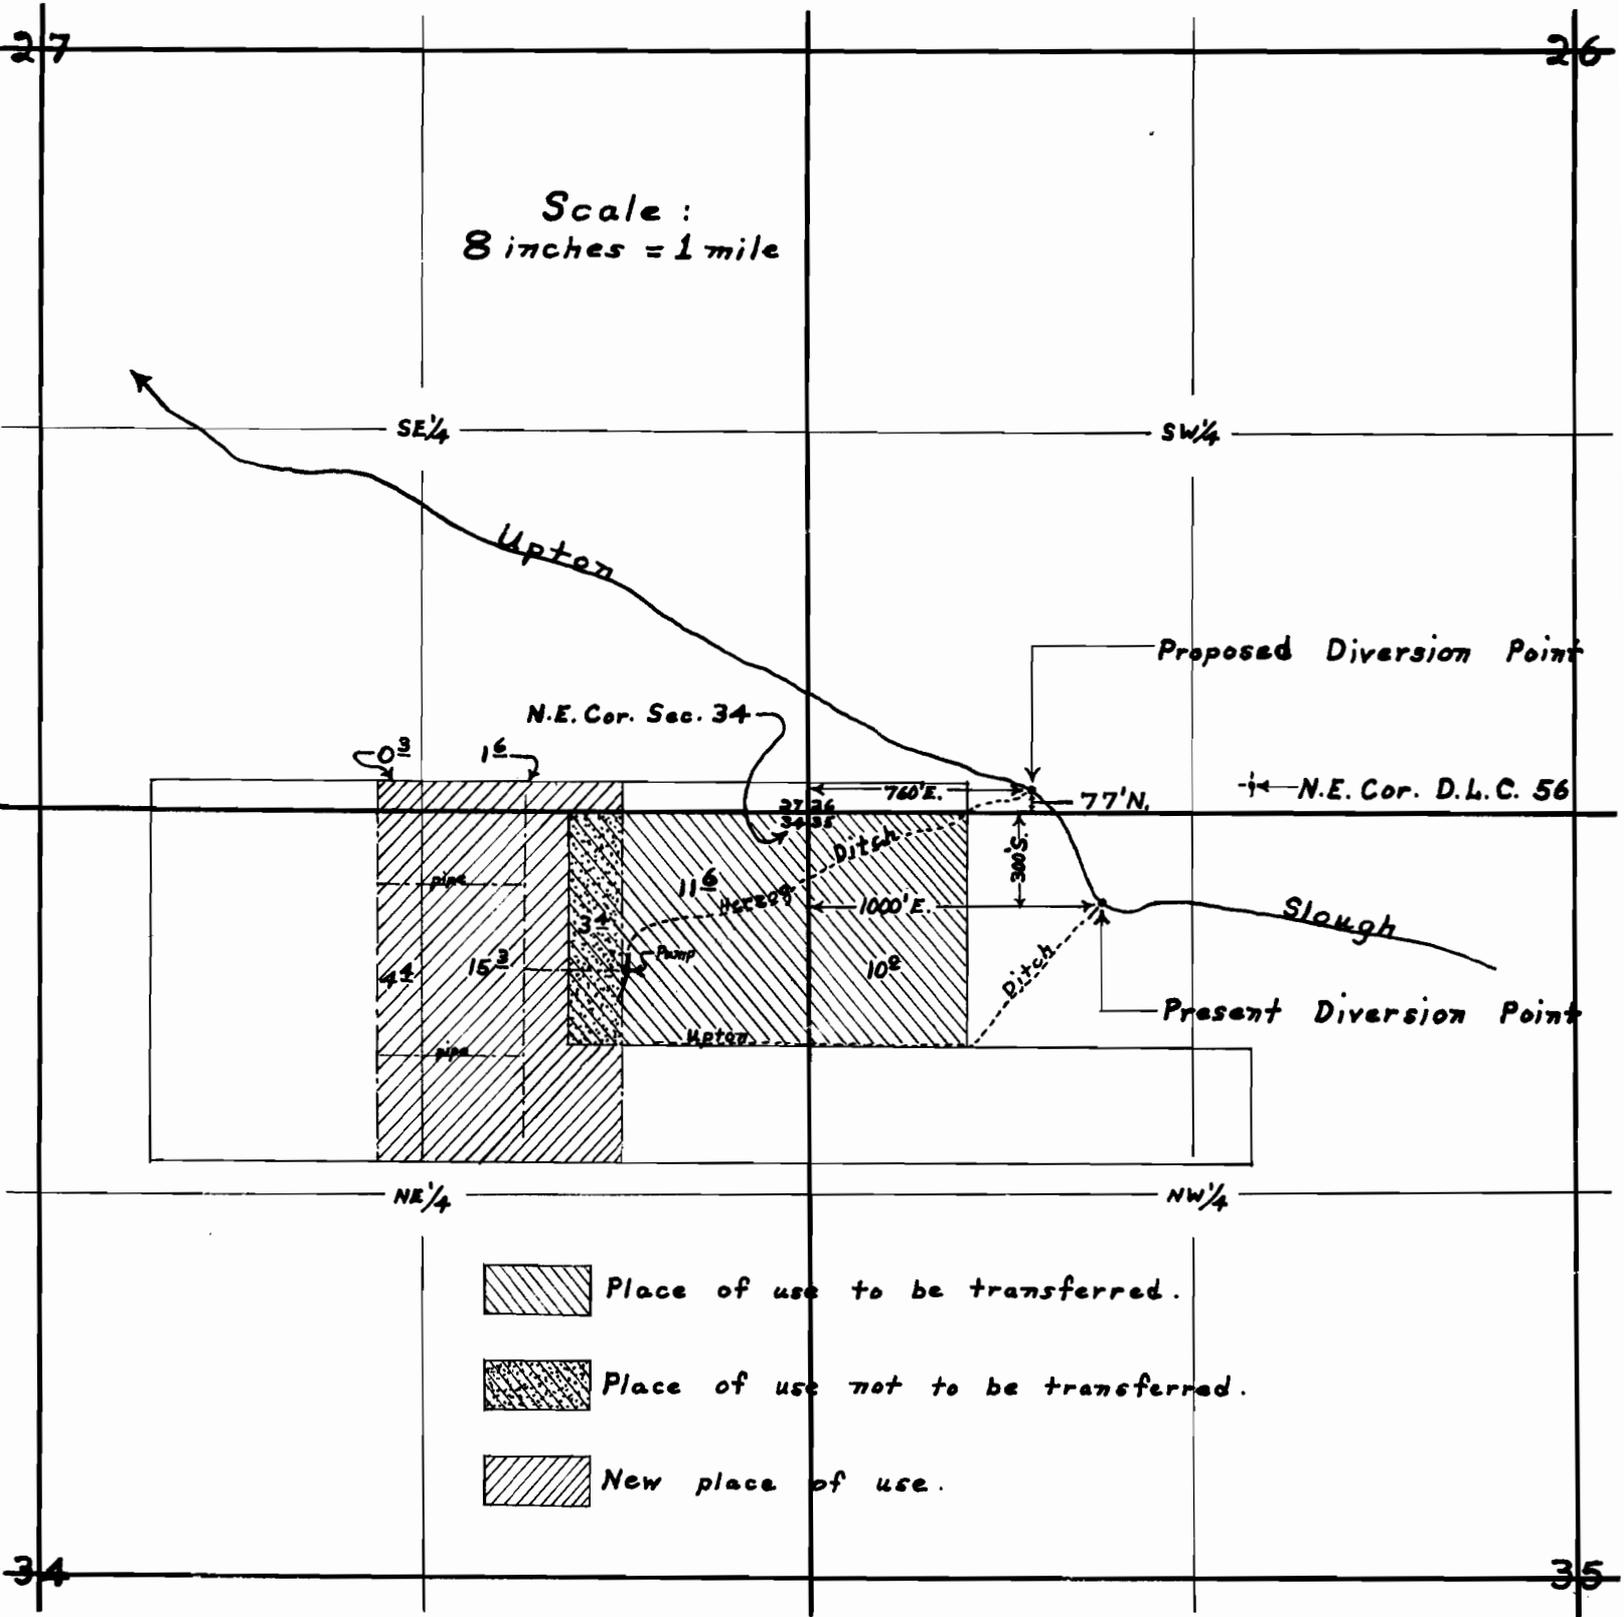

Map to accompany application of Walter H. Herzog for a change in place of use and change in point of diversion of water from Upton Slough.

This Office - July 12, 1955

David C. Hendrix, Watermaster