


T.6S.R.IW.W.M.

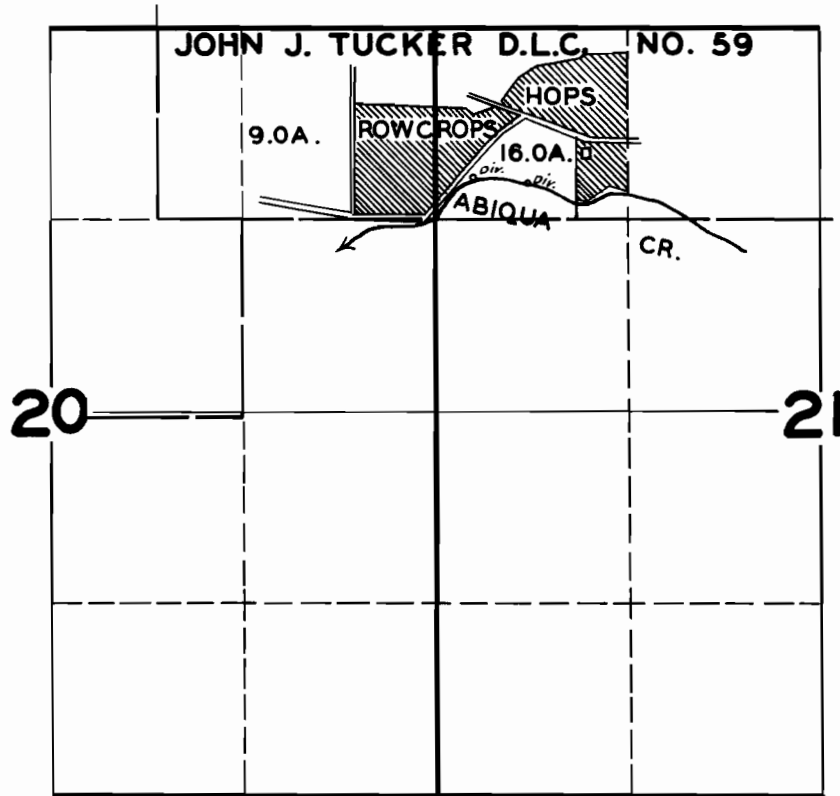

**FINAL PROOF SURVEY
UNDER**

Application No. 19742 Permit No. 15329

IN NAME OF

JOSEPH B. GAFFKE

Surveyed OCT. 6, 1947, by JAS. E. BUNNELL