


# T. 1 N. R. 13 E. W.M.

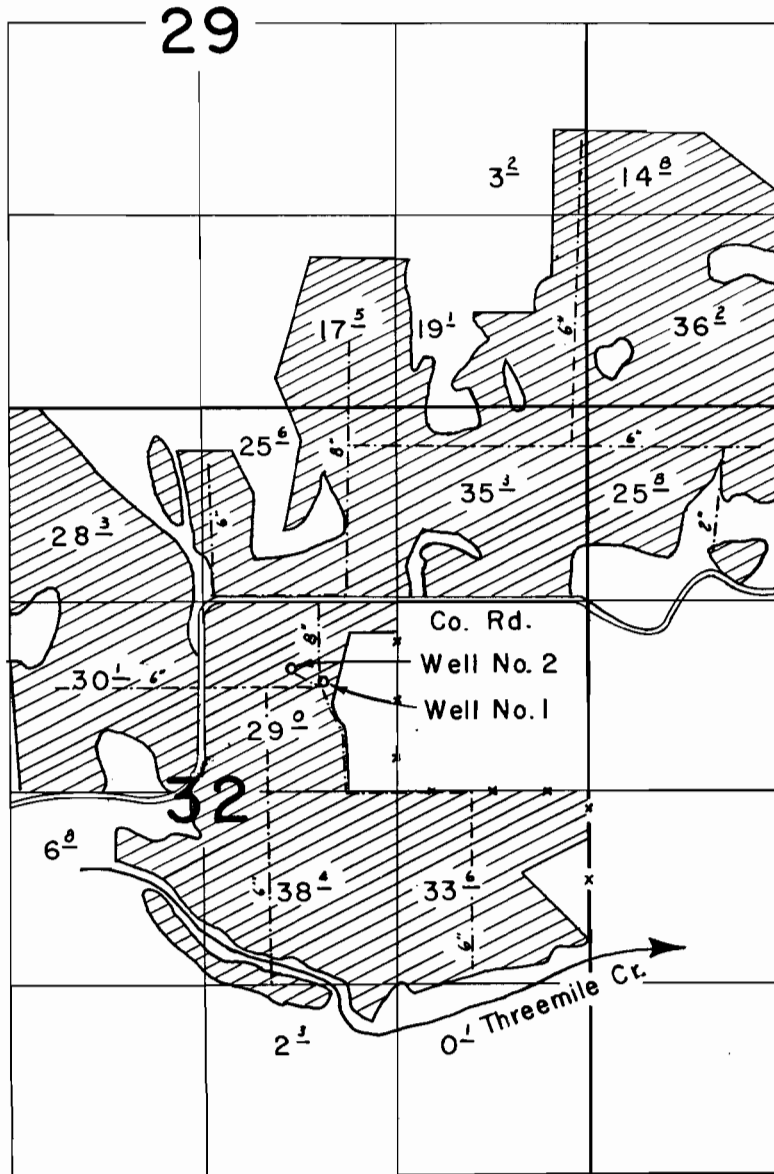

## FINAL PROOF SURVEY UNDER

G- 8 G- 482  
Application No. G-66..... Permit No. G-485..  
IN NAME OF

MILTON F. MARTIN

Surveyed June 6, 1962, by *P. W. J. J. J. J.*