


T.7E.8S.R.41E.42E.W.M.

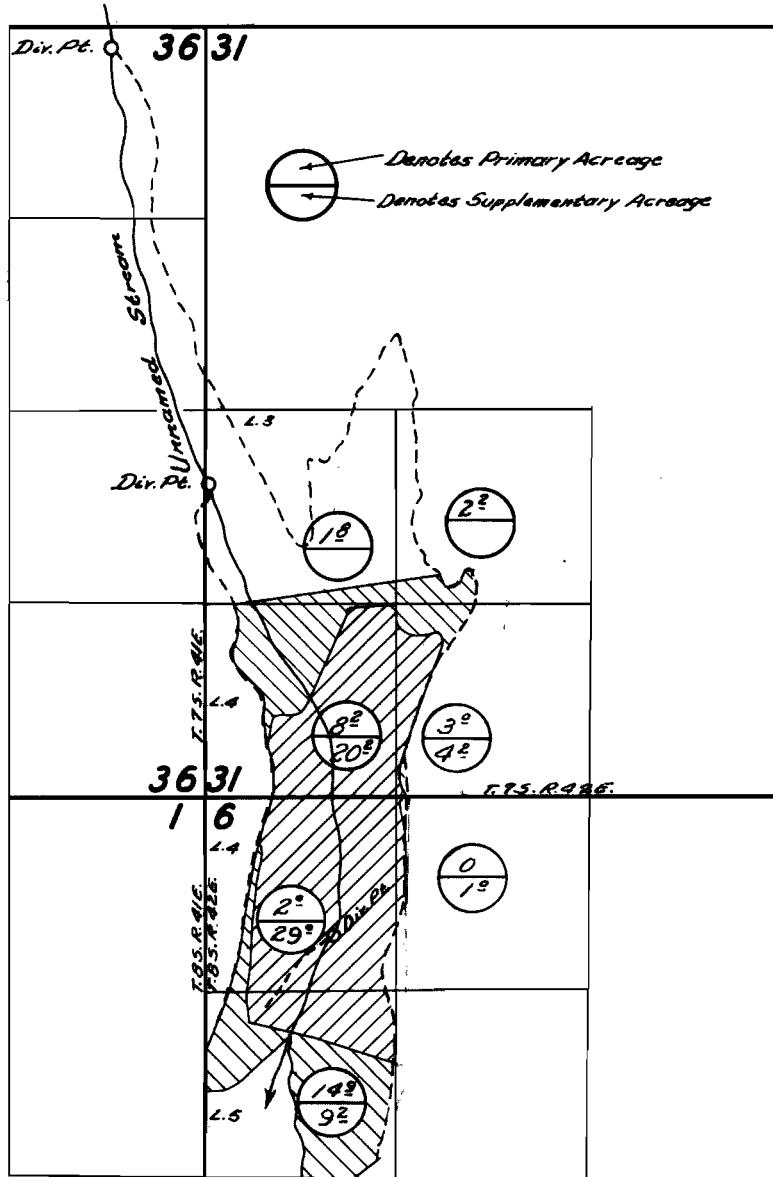

FINAL PROOF SURVEY
UNDER

Application No. 19718 Permit No. 15319
IN NAME OF

Sidney Crisp

Surveyed *May 28*, 1956, by *M. Bish*