


T.12S.R.4&5W.W.M.

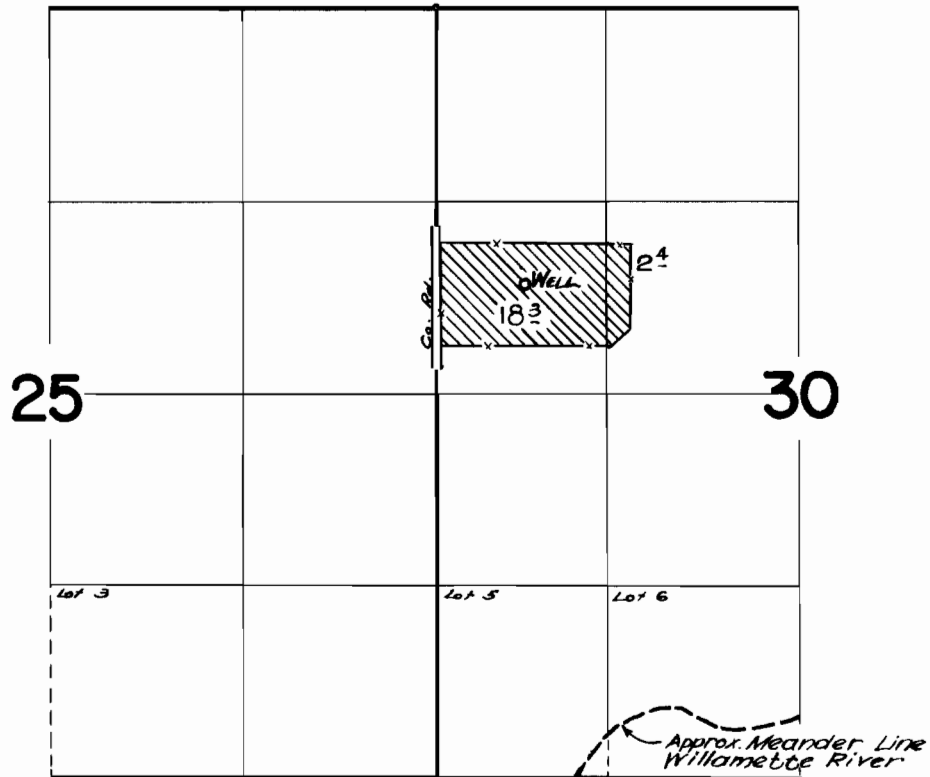

FINAL PROOF SURVEY
UNDER

Application No. G-1822 Permit No. G-1665
IN NAME OF

LEONARD E. GILES

Surveyed April 22 1963, by C. Baker