


T.13&14 S.R.5 W.W.M.

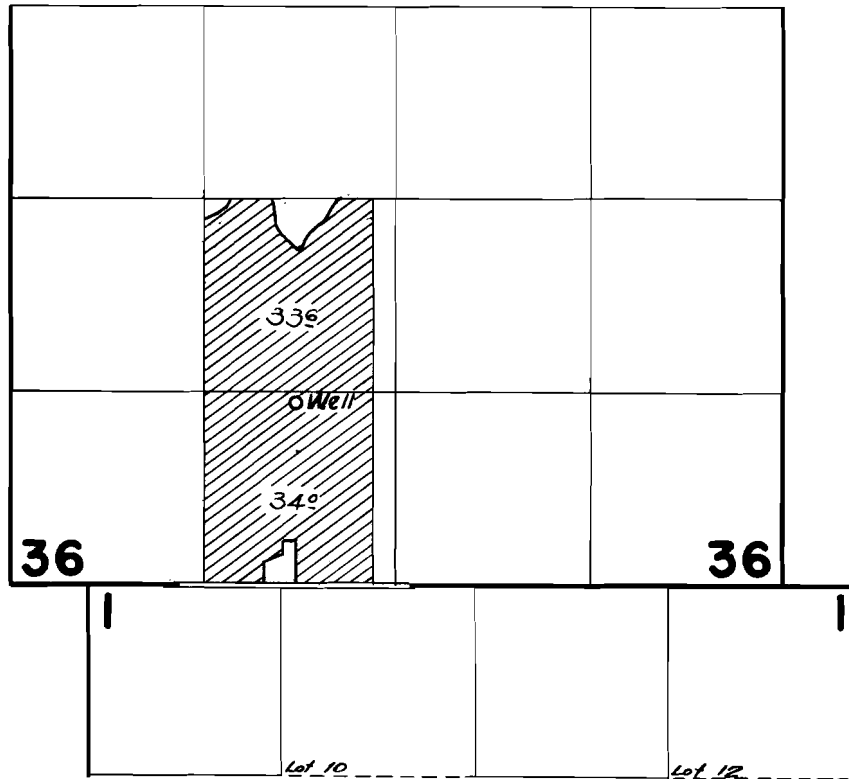

FINAL PROOF SURVEY UNDER

Application No. **G-2027**. Permit No. **G-1865**.
IN NAME OF

IVAN M. HORNING

Surveyed *April 24* 1963, by *C. Baker*