


T.14S.R.8W.W.M.

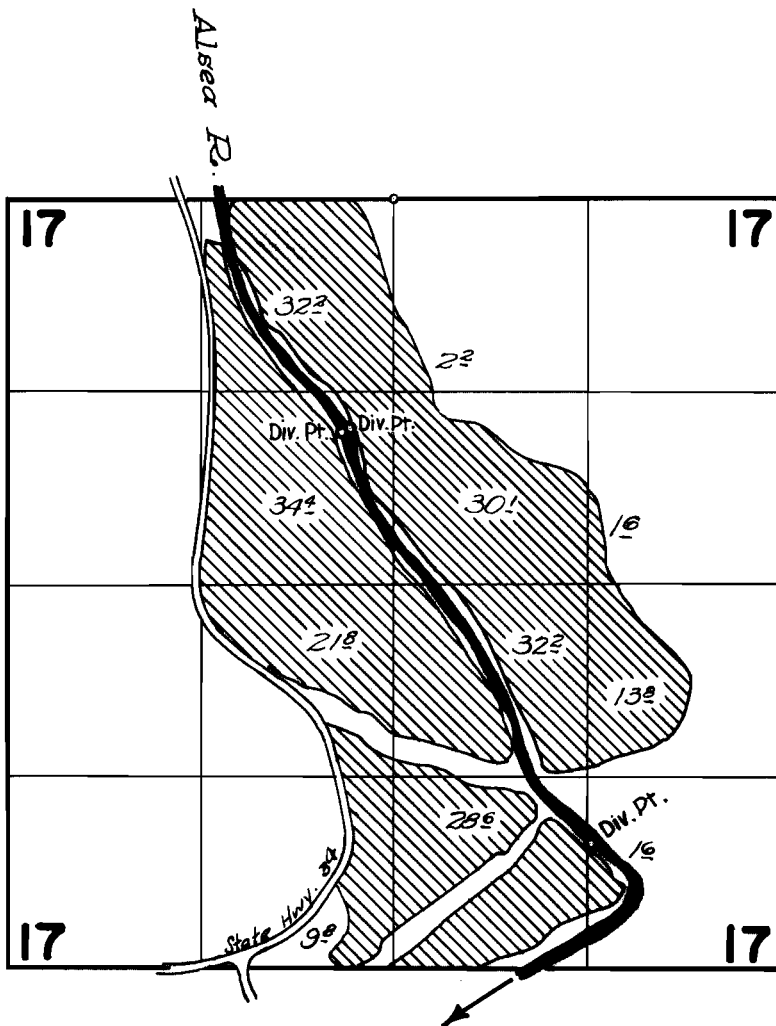

FINAL PROOF SURVEY
UNDER

Application No. 27926 Permit No. 21995
IN NAME OF

GEORGE SHROYER

Surveyed April 30 1963, by C. Baker