


T.14S.R.4&5W.W.M.

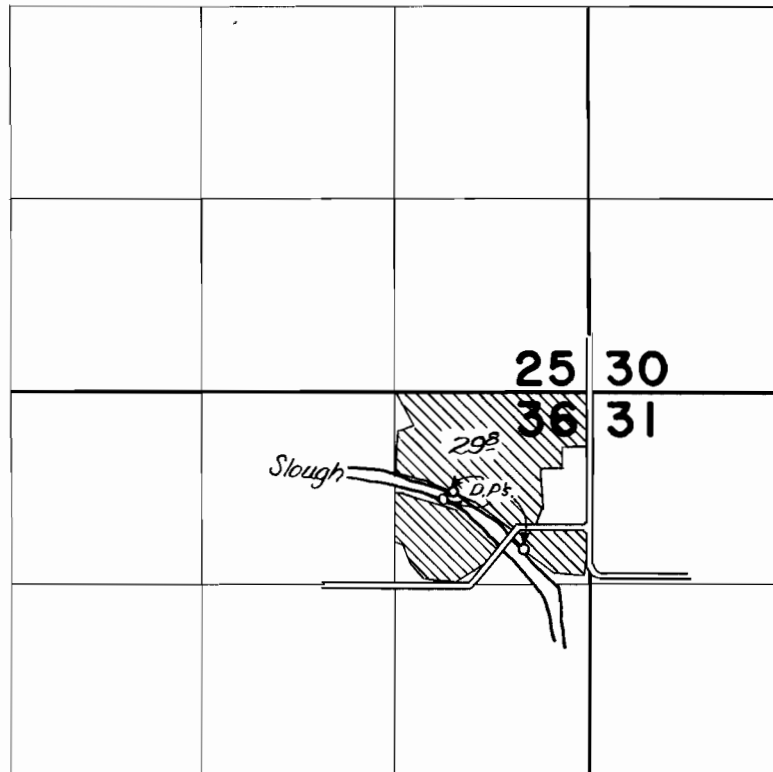

FINAL PROOF SURVEY
UNDER

Application No. **32505** Permit No. **25681**
IN NAME OF

JAMES R. & MILDRED CROWSON

Surveyed *May 3 1963*, by *C. Baker*