


T.10S.R.7 W.W.M.

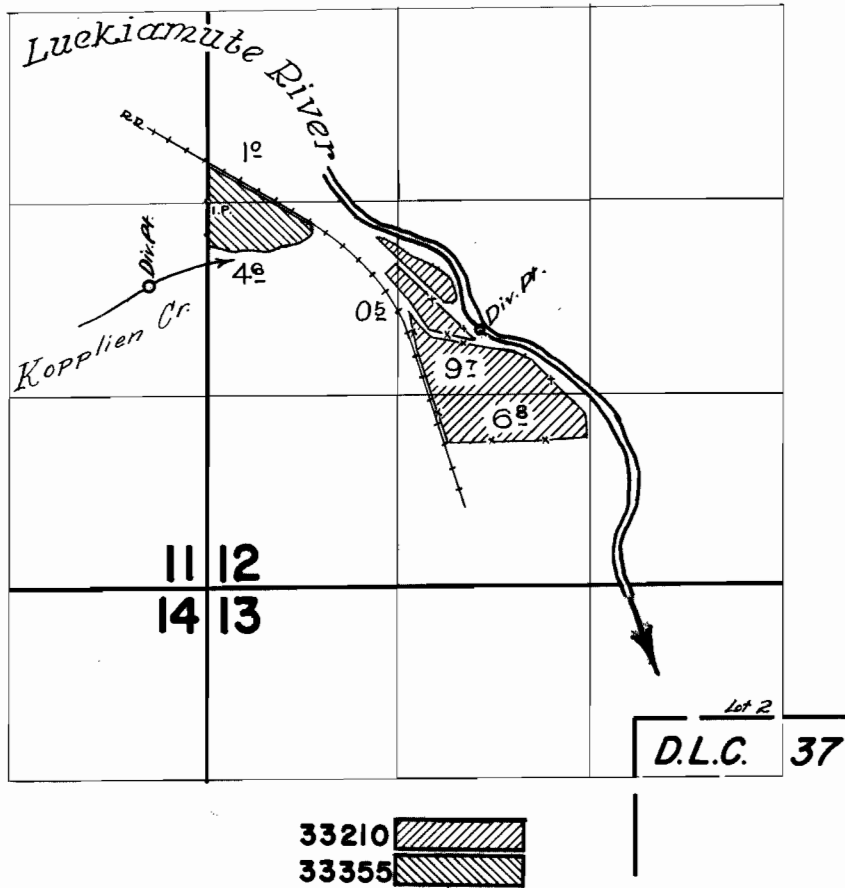

FINAL PROOF SURVEY UNDER

Application No. **33210** **26277**
33355 Permit No. **26372**
IN NAME OF

FRED P. KRAUSE

Surveyed *April 26 1963*, by *C. Baker*.....