


# T.10S.R.7 W.W.M.

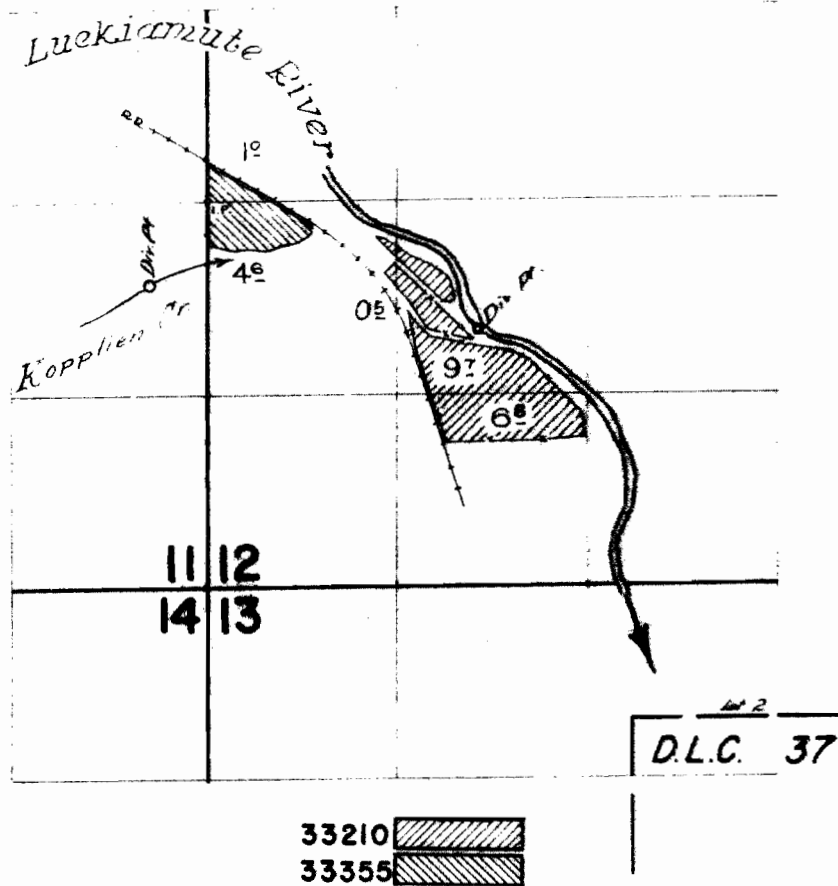

## FINAL PROOF SURVEY UNDER

Application No. **33210** **33355** Permit No. **26277** **26372**  
IN NAME OF

**FRED P. KRAUSE**

Surveyed April 26 1963, by C. Baker