


T.10S.R.6 W.W.M.

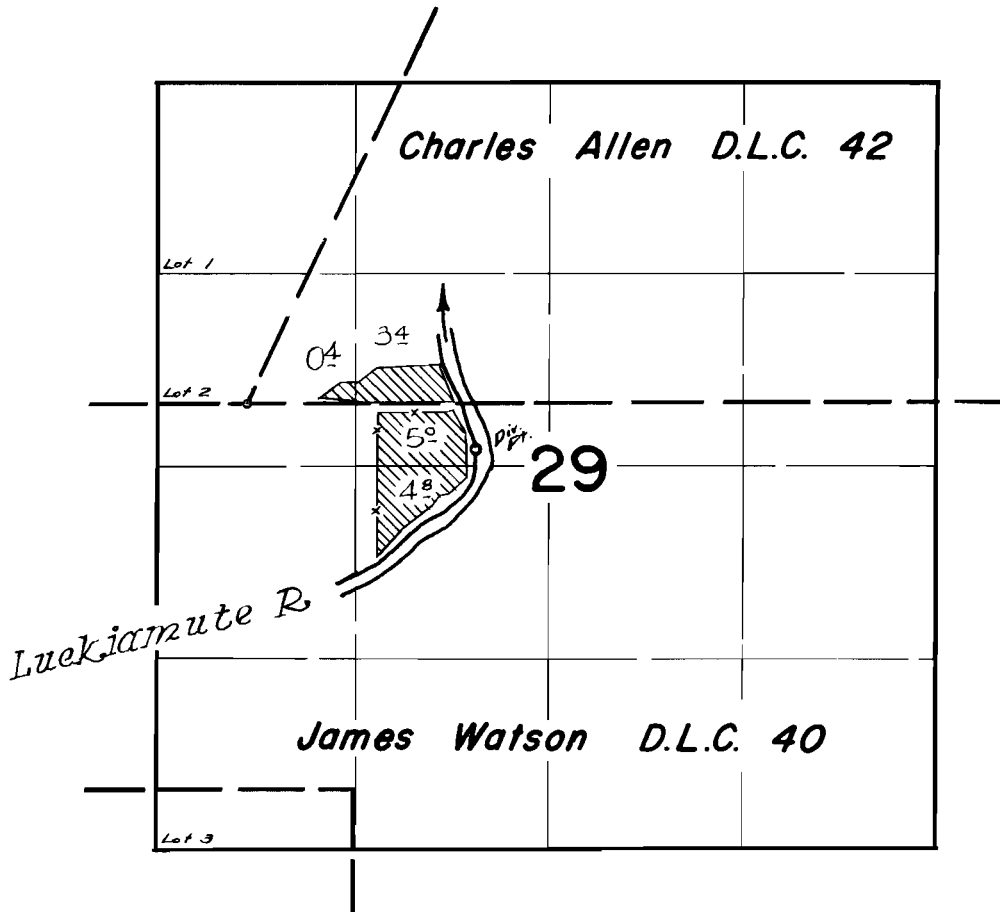

FINAL PROOF SURVEY
UNDER

Application No. **34148** Permit No. **26907**
IN NAME OF

GRACEN L. BUSH

Surveyed *April 26 1963*, by *C. Baker*

