


T.11S.R.7W.W.M.

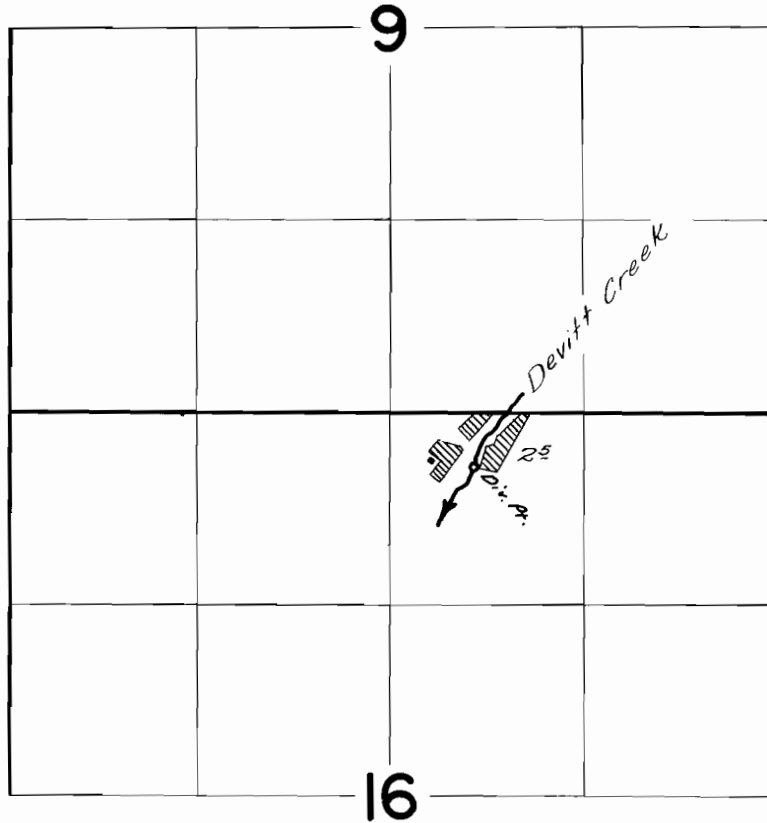

**FINAL PROOF SURVEY**  
UNDER

Application No. **37321** . . . Permit No. **27801** . . .  
IN NAME OF

**GROVER A. CLARK**

Surveyed *April 29 1963* by *C. Baker*