


T.4S. R.3E. W.M.

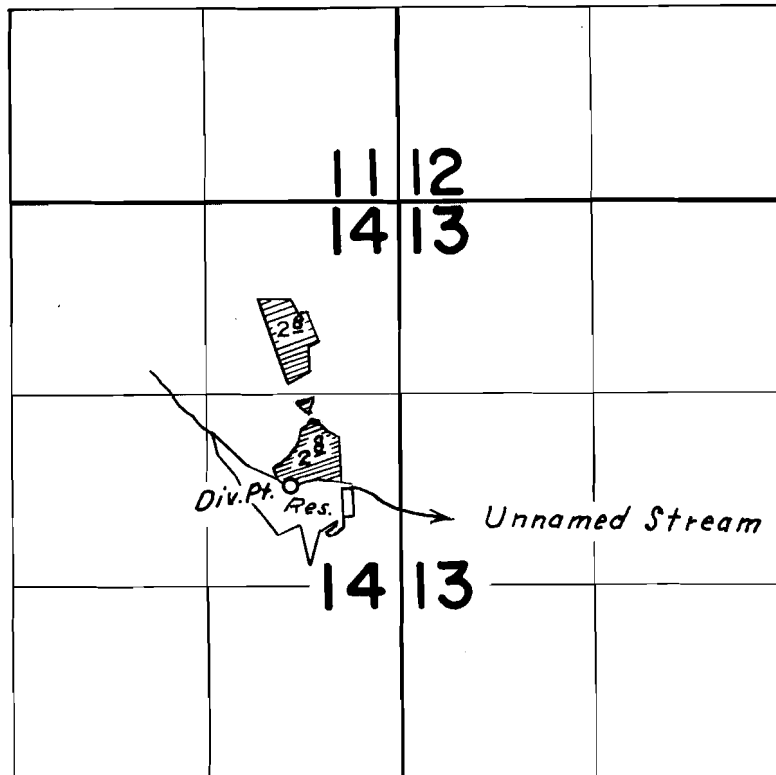

FINAL PROOF SURVEY
UNDER

R-32300 R-2132
Application No. 32301 Permit No. 25494
IN NAME OF

STANLEY J. MITCHELL

Surveyed July 22, 1964, by C. J. Gardner