


# T.29S.R.14W.W.M.

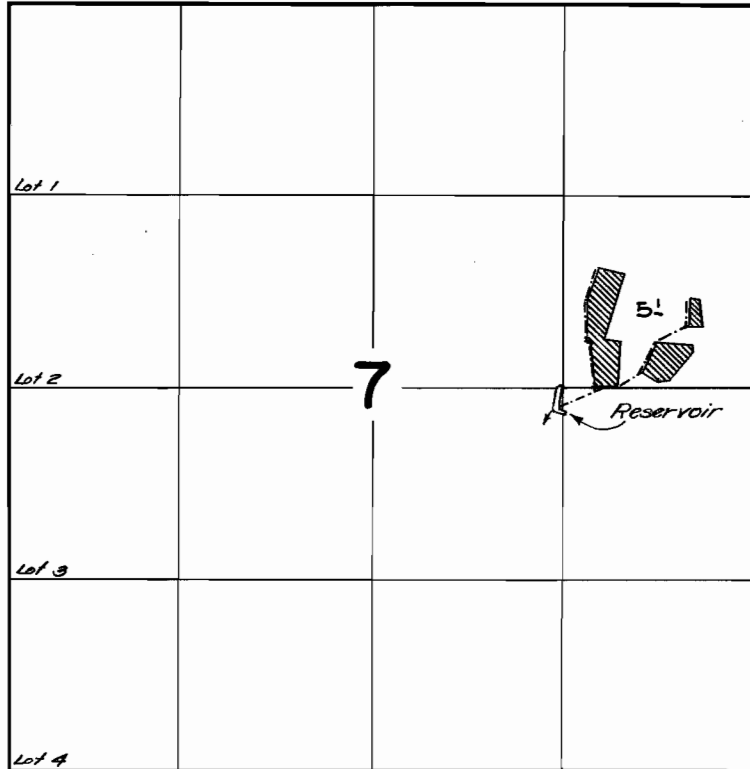

## FINAL PROOF SURVEY UNDER

R-30809                      R-1672  
Application No. 30810    Permit No. 24293  
IN NAME OF

H. R. INKS

Surveyed August 14, 1963, by C. Baker  
March 16, 1965, by R. Jackson