


T.29S.R.14W.W.M.

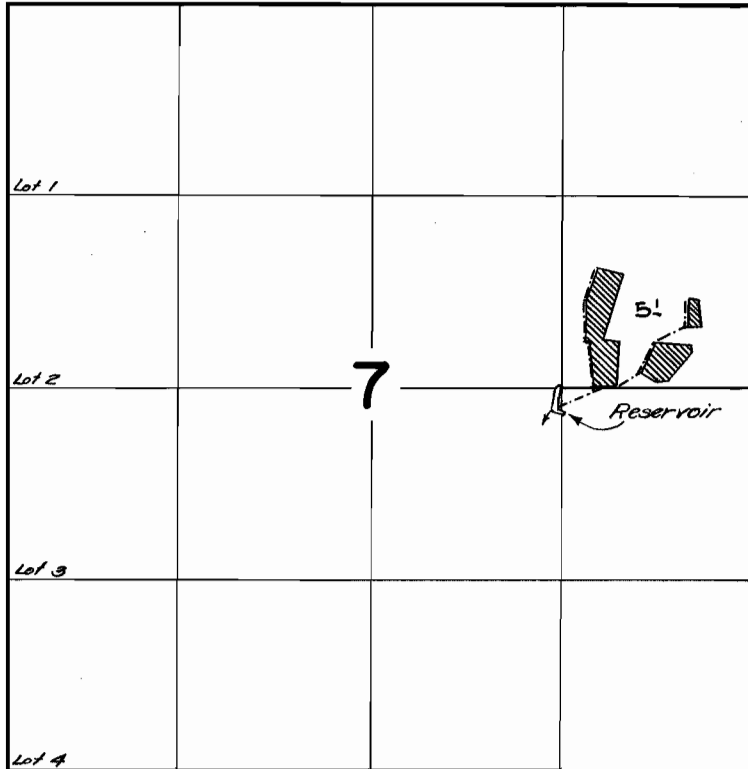

FINAL PROOF SURVEY UNDER

R-30809 R-1672
Application No. 30810 Permit No. 24293
IN NAME OF

H. R. INKS

Surveyed August 14, 1963, by C. Baker
March 16, 1965, by R. Jackson