


T.28S.R.14 W.W.M.

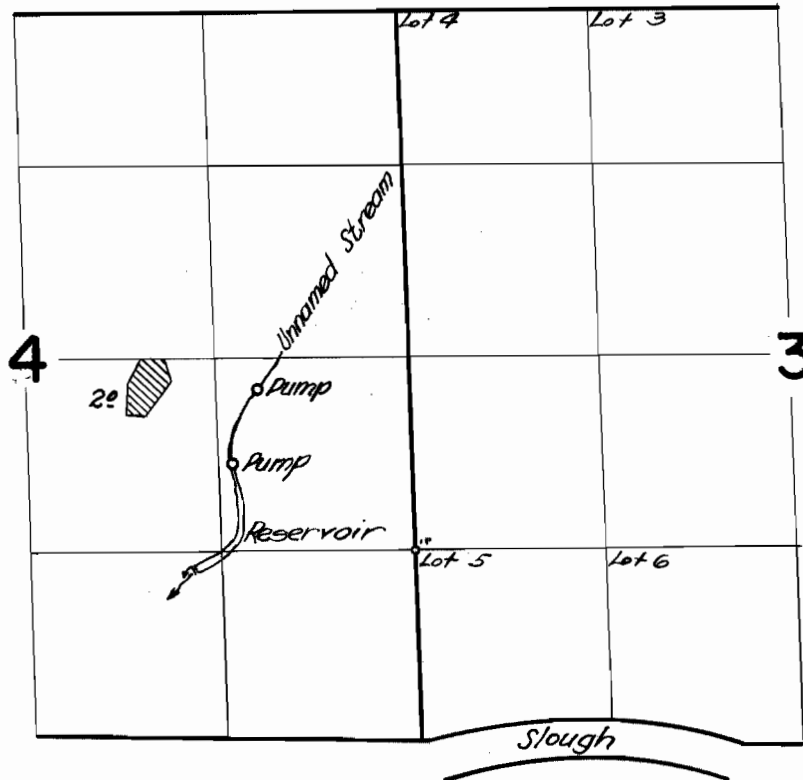

**FINAL PROOF SURVEY**  
UNDER

Application No. 37418 Permit No. 28270  
IN NAME OF

DELBERT C. & KATHLEEN RUDELL

Surveyed August 12 1963, by C. Baker

*AK*