


Basin 5 Dist. 11
T7341
32421

T.17S.R.21E.W.M.

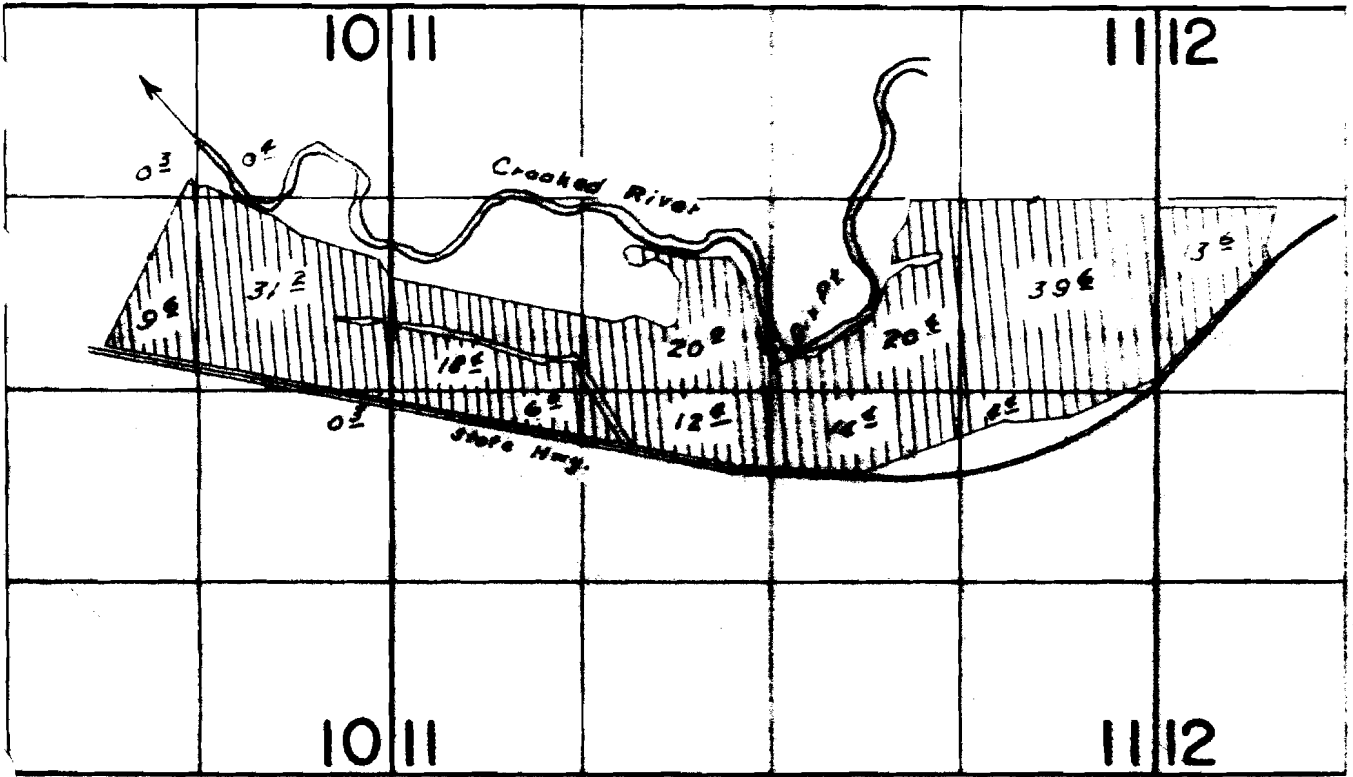

FINAL PROOF SURVEY
UNDER

Application No. 33016 . Permit No. 26104
IN NAME OF

LES SCHWAB

Surveyed Sept. 8, 1964, by C. W. Gardner.

#26104
1964-P
26104