


T.41S.R.13 W.W.M.

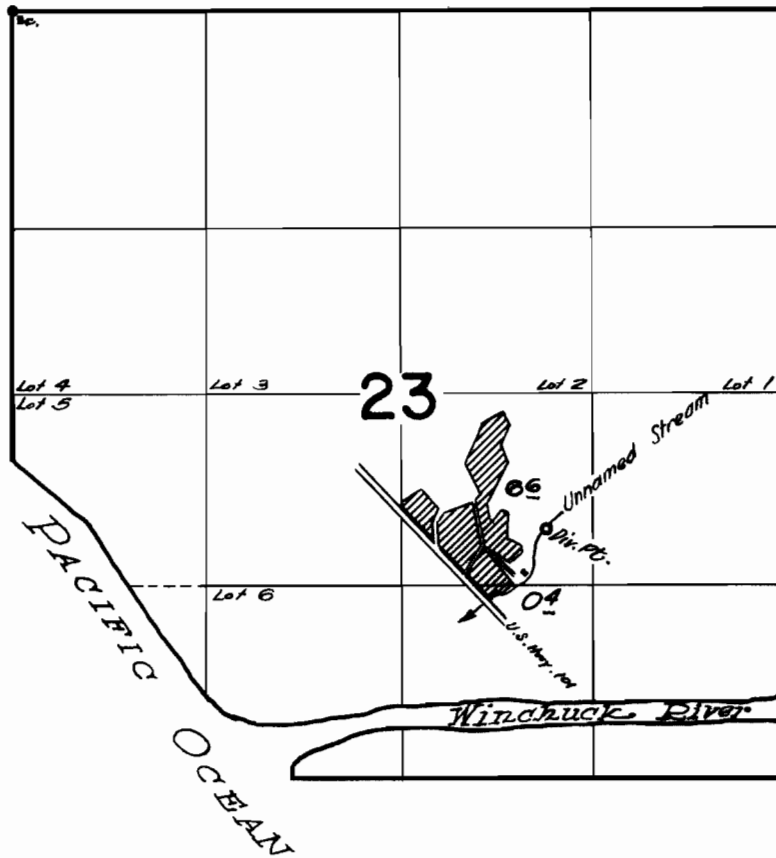

FINAL PROOF SURVEY UNDER

Application No. 30475 Permit No. 24071.....
IN NAME OF

OTTO C. & MARJORIE R. TURLEY

Surveyed ^{August 4, 1961} ~~March 10, 1965~~ by *R. Jackson*