


T.41S.R.13W.W.M.

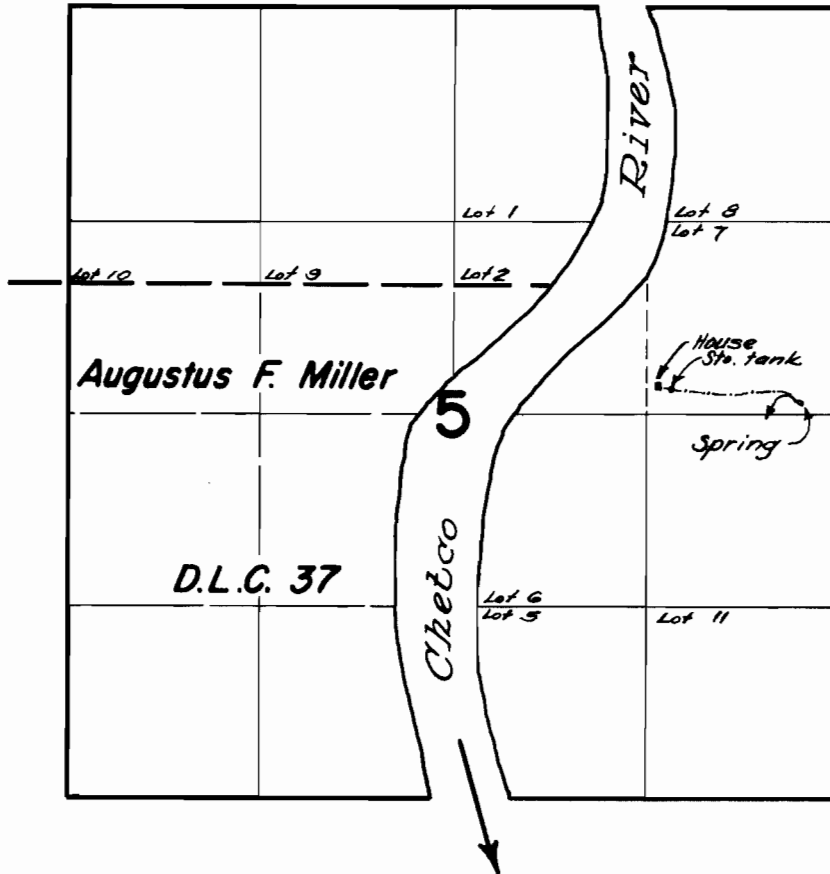

FINAL PROOF SURVEY UNDER

Application No. 32637... Permit No. 25743...
IN NAME OF

B. A. MCVAY

Surveyed August 8, 1963, by T. Lauer...
March 16, 1965, by R. Jackson