


T.37S.R.14W.W.M.

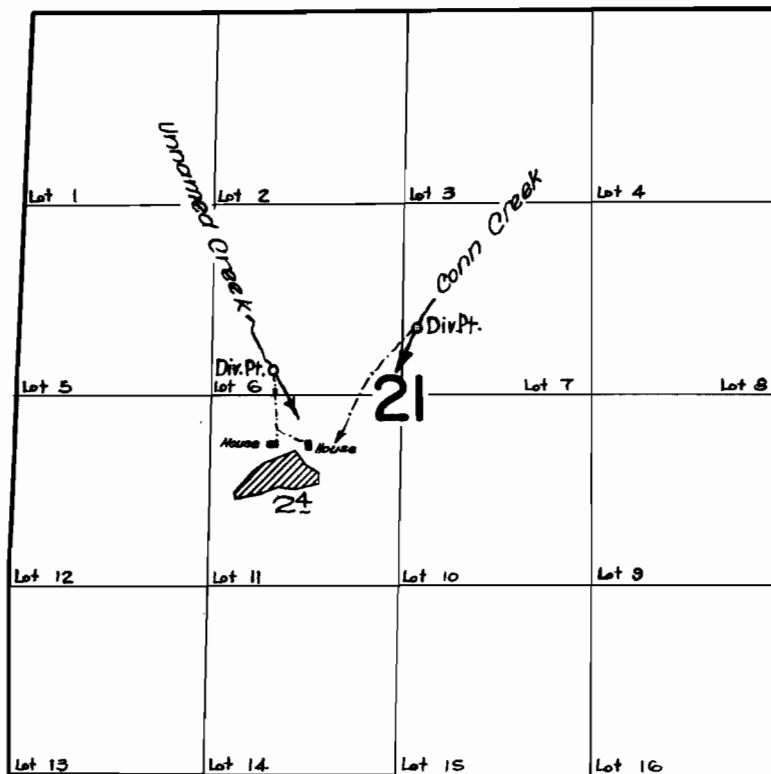

FINAL PROOF SURVEY
UNDER

Application No. 33042 Permit No. 26184
IN NAME OF

J. C. & HAZEL I. LEITH

Surveyed August 13 1963, by T. Lauer