


T.27S.R.6W.W.M.

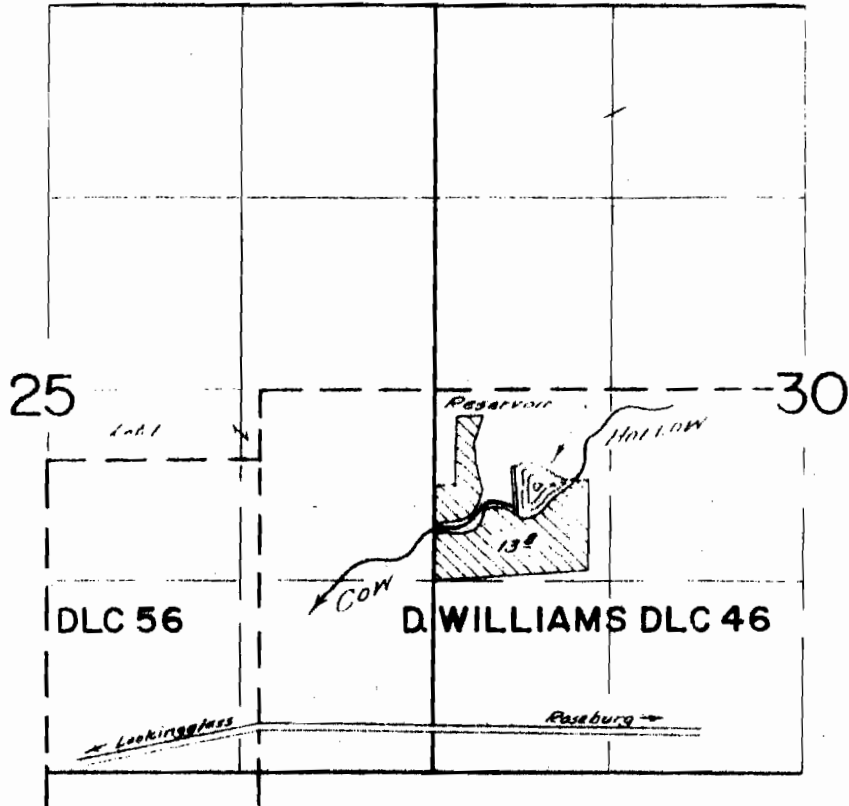

FINAL PROOF SURVEY
UNDER

Application No. R-31087
31088 Permit No. R-1930
24468
IN NAME OF

Ardell Loerts

Surveyed Feb. 28 1964, by C.O. Bartals

RECEIVED

NOV 20 2002

WATER RESOURCES DEPT.
SALEM, OREGON