


T.30S.R.3&4W.W.M.

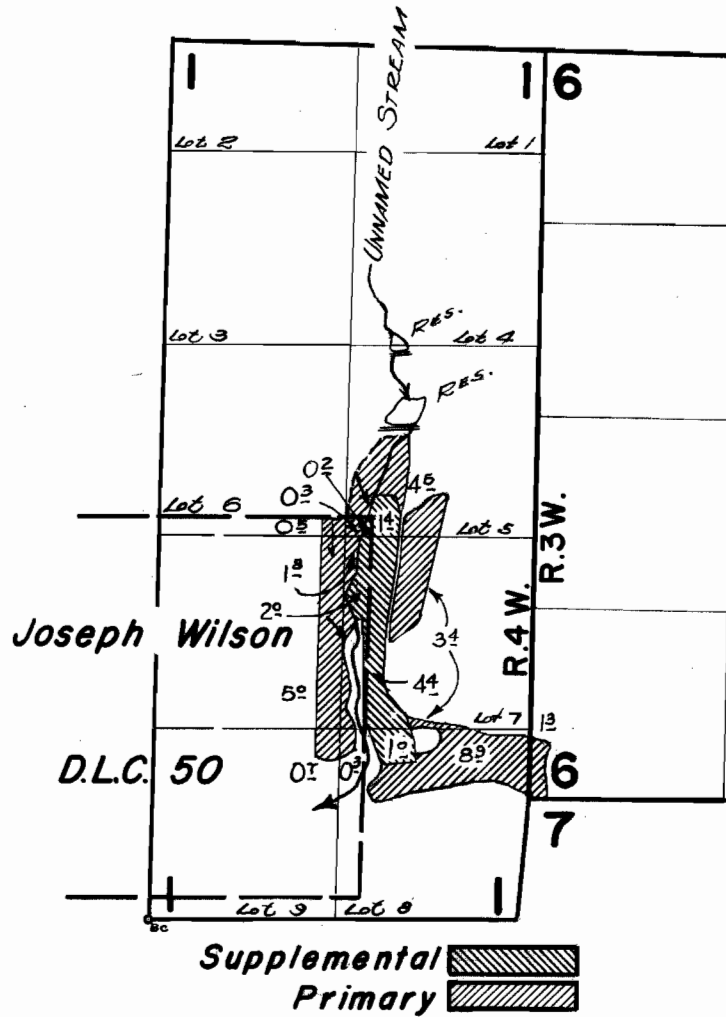

FINAL PROOF SURVEY UNDER

R-31491 R-2052
 Application No. 31688 Permit No. 25030
 IN NAME OF

Marvin E. & Olive Sheldon

Surveyed July 8, 1963, by C. O. Bartels