


R-2654
 32429
 32430 R. 2655
 32431 R. 2654

T.13S. R.27E. W.M.

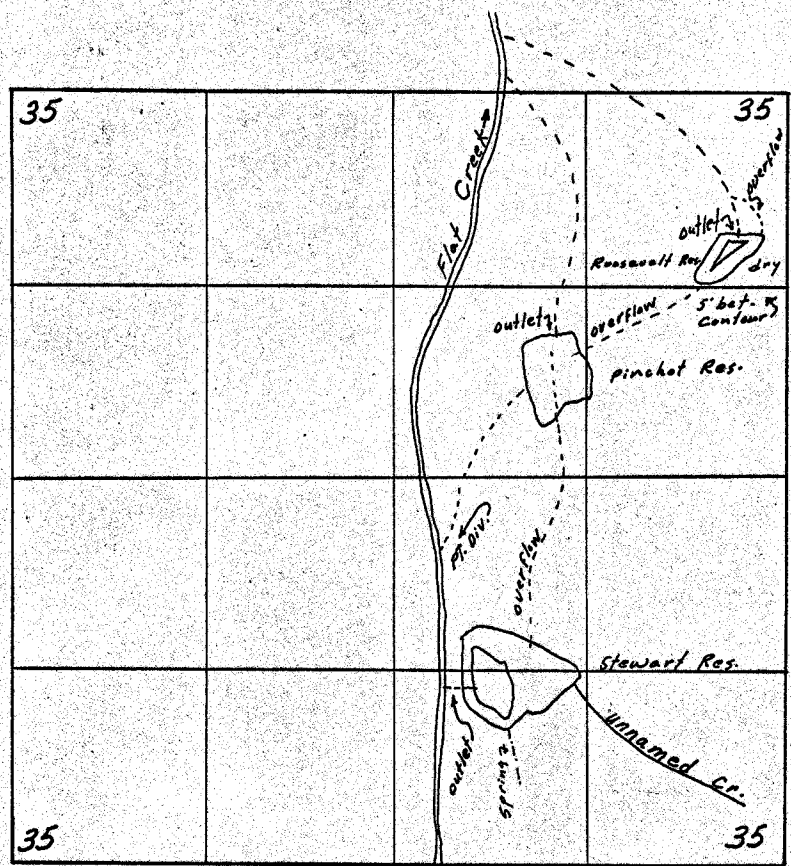

FINAL PROOF SURVEY
 UNDER

Application No. R-34850 Permit No. R-2654
R-34851 R-2655
 IN NAME OF

Pine Tree Lumber Company

Surveyed June 25 1964, by G. Ward