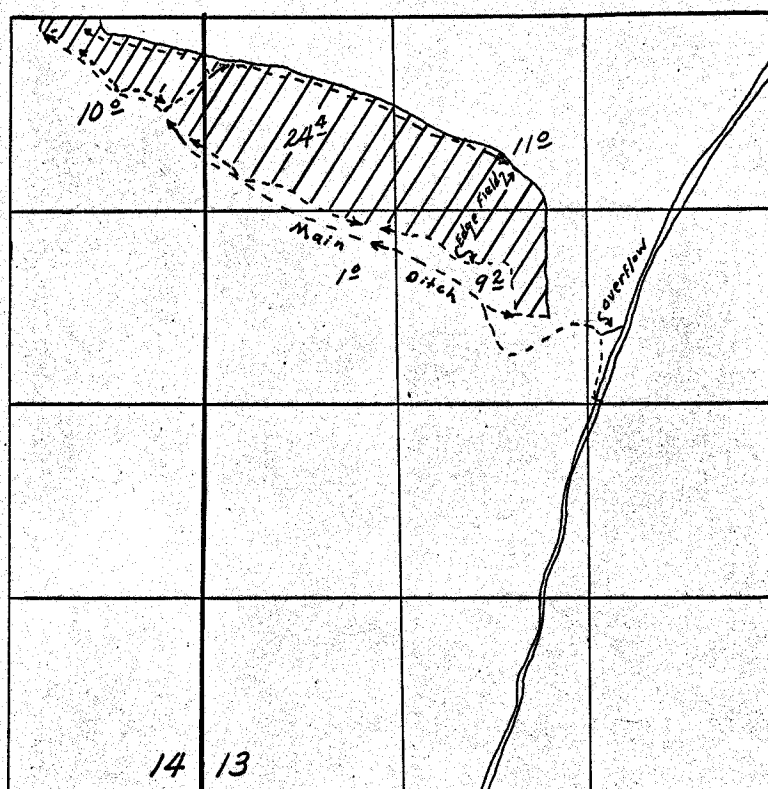


T.13S. R.27E. W.M.

**FINAL PROOF SURVEY**
UNDERApplication No. 34853 Permit No. 27524
IN NAME OFPine Tree Lumber CompanySurveyed June 26 1964, by G. Ward