


T.39S.R.35E.W.M.

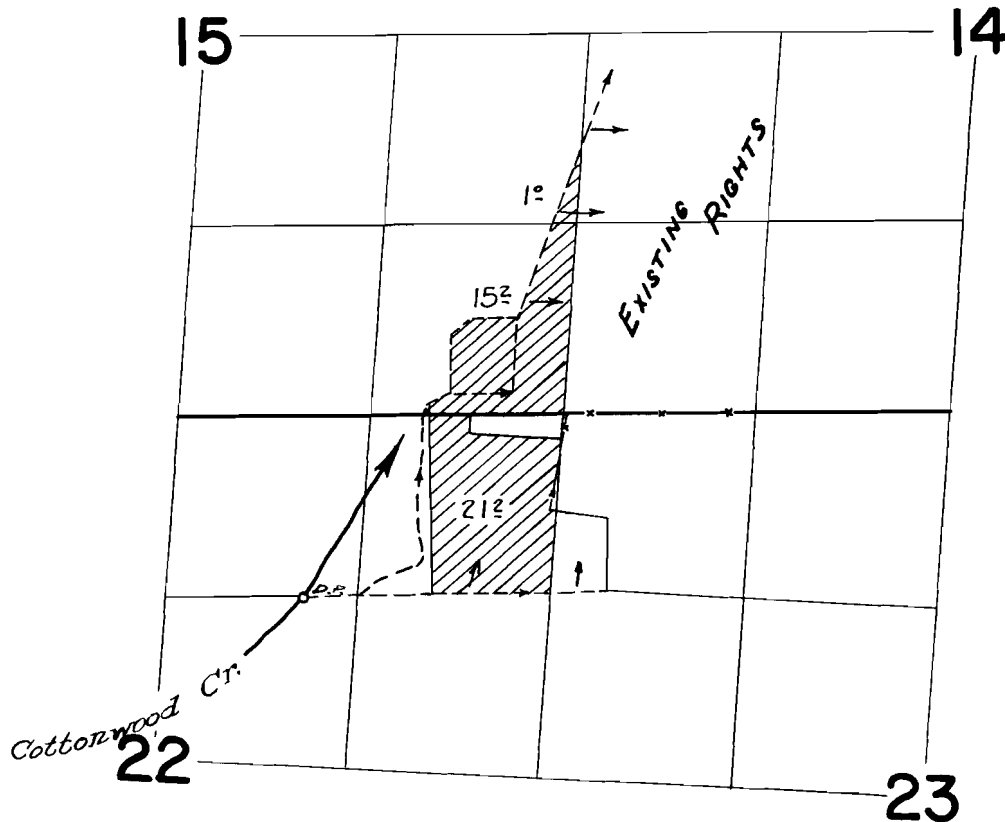

**FINAL PROOF SURVEY**  
UNDER

Application No. 19663. Permit No. 15244.  
IN NAME OF

**ESTATE OF E. F. SMITH**

Surveyed Aug. 27 1963 by C. D. BAKER