


T.37S.R.2E.W.M.

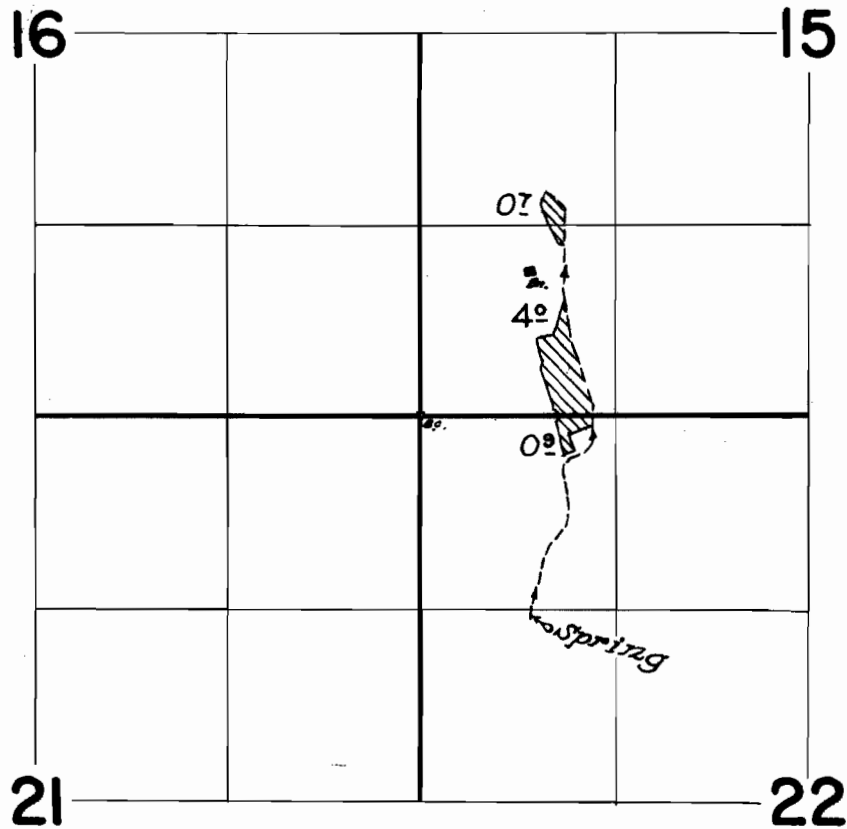

FINAL PROOF SURVEY
UNDER

Application No. 28902 Permit No. 22668
IN NAME OF

.....KENNETH B. OWEN.....

Surveyed June 13, 1963, by C. R. Baker.....