


T.35S. R.3W. W.M.

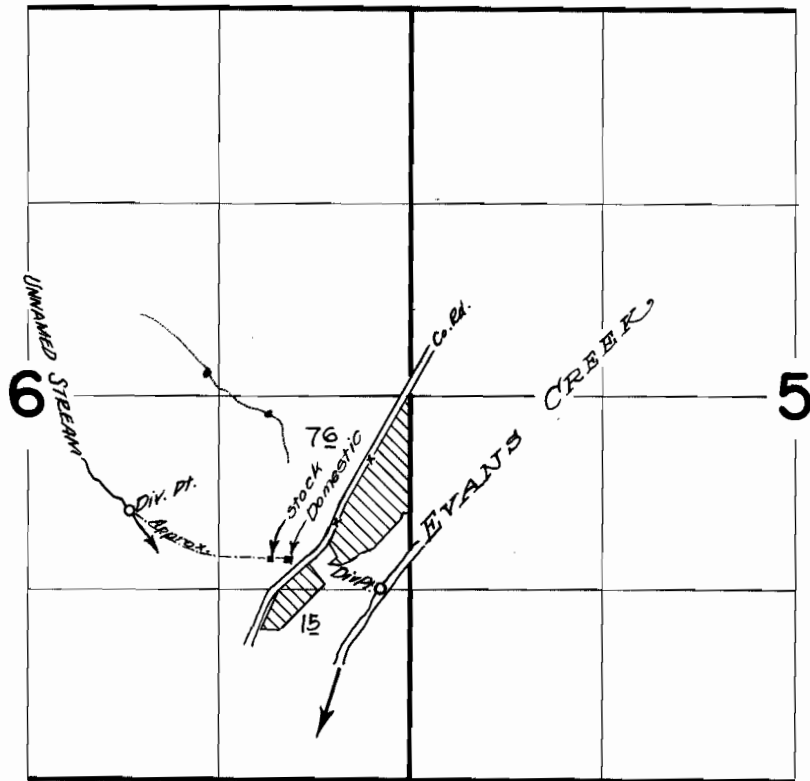

FINAL PROOF SURVEY
UNDER

Application No. 31394... Permit No. 24748..
IN NAME OF

..... FULTON R. WILLIAMS

Surveyed April 16 1962, by C. R. Baker...