


T.36S.R.2W.W.M.

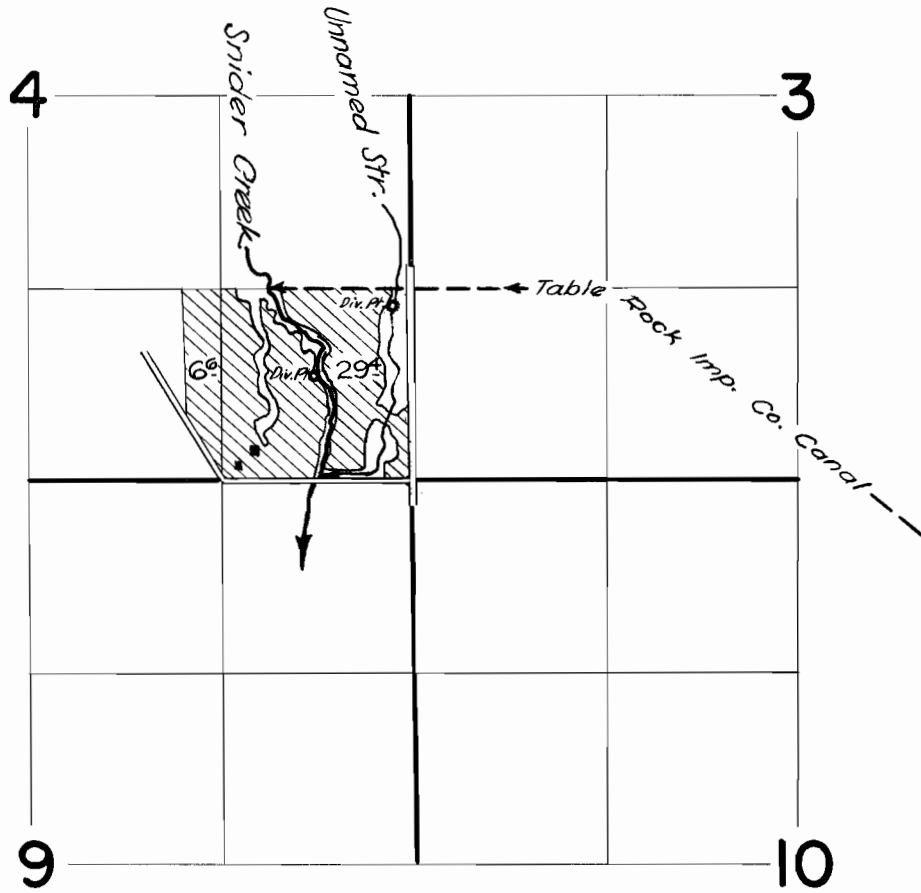

FINAL PROOF SURVEY

UNDER

31443

24798

32331

25509

Application No. 33485 Permit No. 26472

IN NAME OF

GUY O. NELSON

Surveyed June 11, 1963, by C.R. Baker