


T.35S.R.2W.W.M.

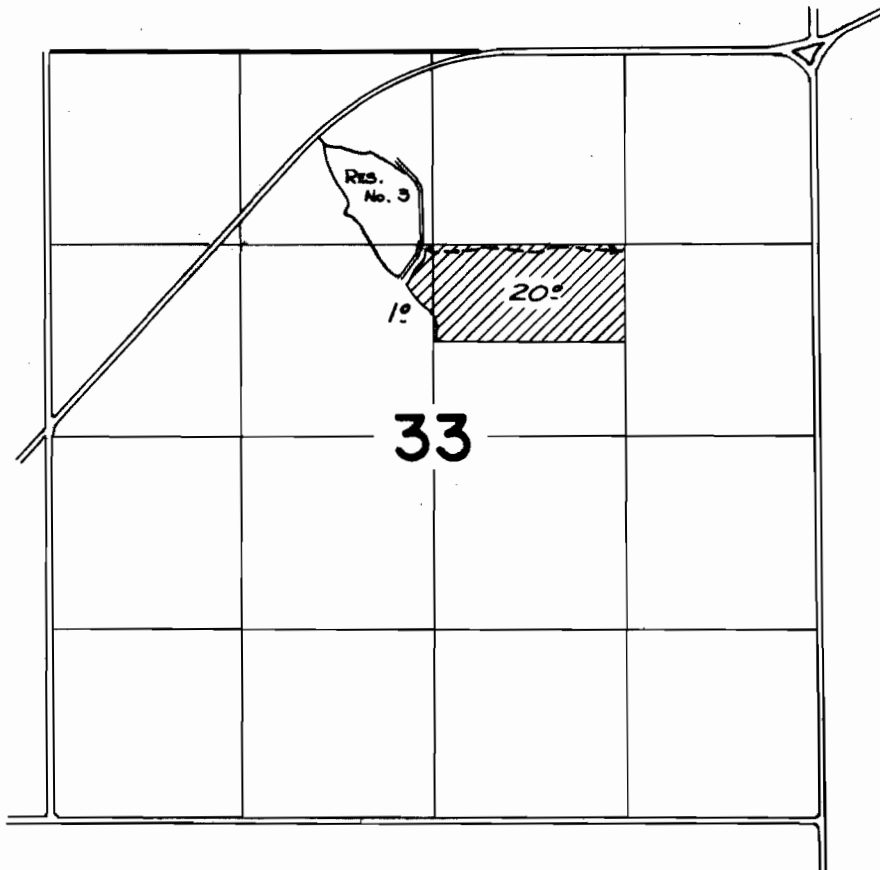

**FINAL PROOF SURVEY**  
UNDER

R-33248                      R-2280  
Application No. 33248 Permit No. 26394...  
IN NAME OF

**LESTER E. JAMES**

Surveyed July 11, 1963, by C. Baker.....