


T.35S.R.2W.W.M.

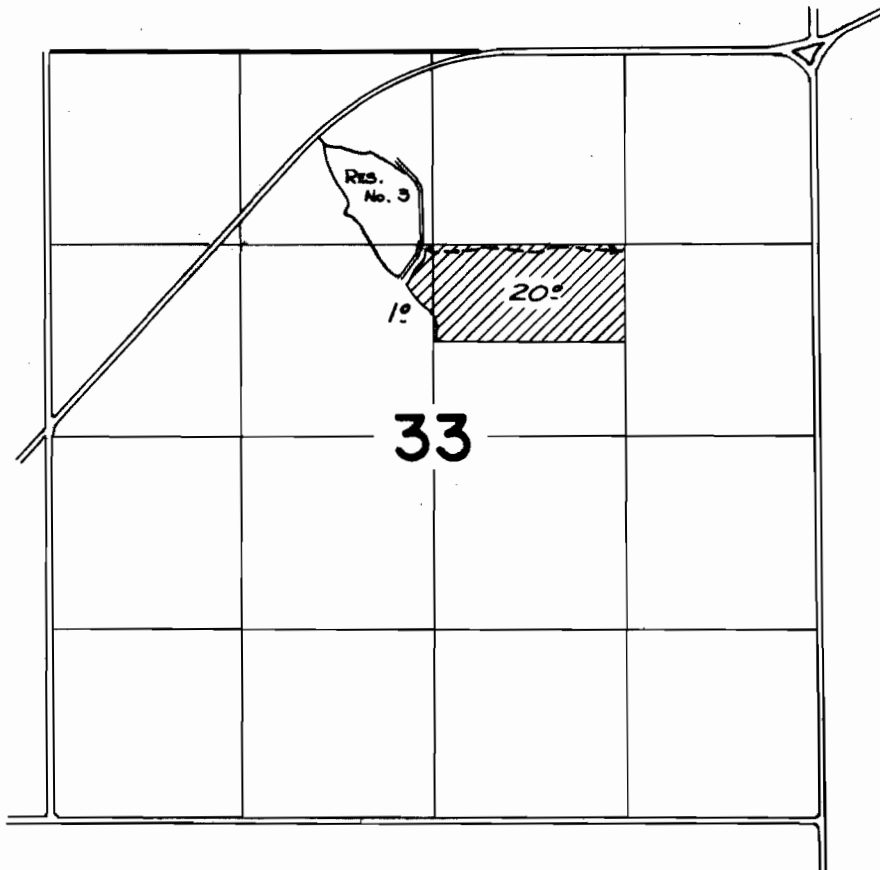

FINAL PROOF SURVEY
UNDER

R-33248 R-2280
Application No. 33248 Permit No. 26394...
IN NAME OF

LESTER E. JAMES

Surveyed July 11, 1963, by C. Baker.....