


T.38S.R.3W.W.M.

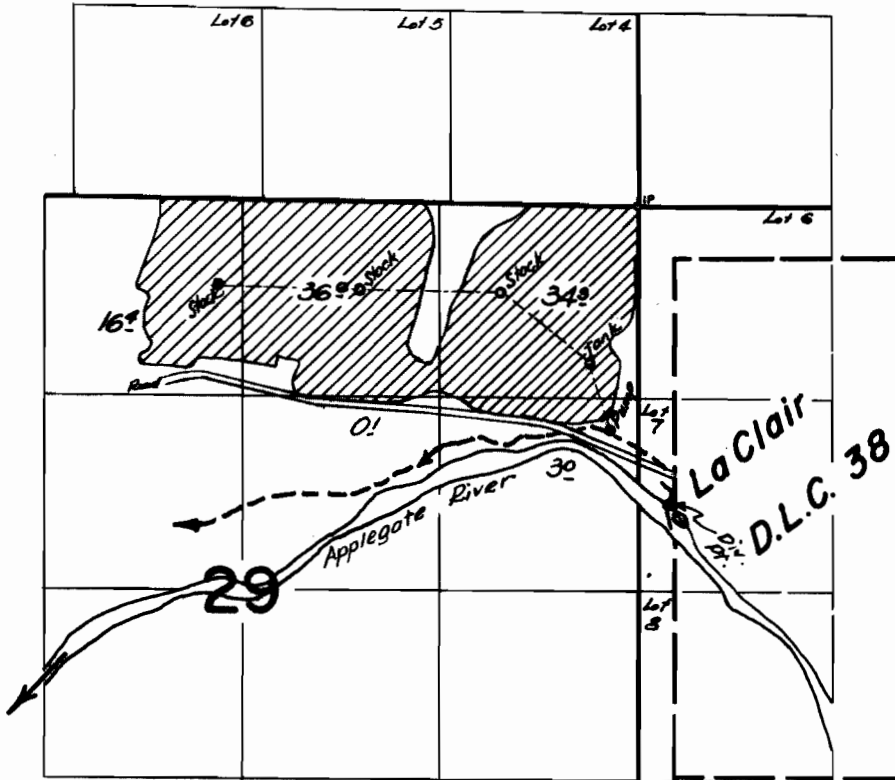

FINAL PROOF SURVEY UNDER

Application No. 33282... Permit No. 26693...
IN NAME OF

.....HARTS HATCHERY INC.....

Surveyed June 6, 1963, by C.R. Baker...