


# T.35S.R.1W.W.M.

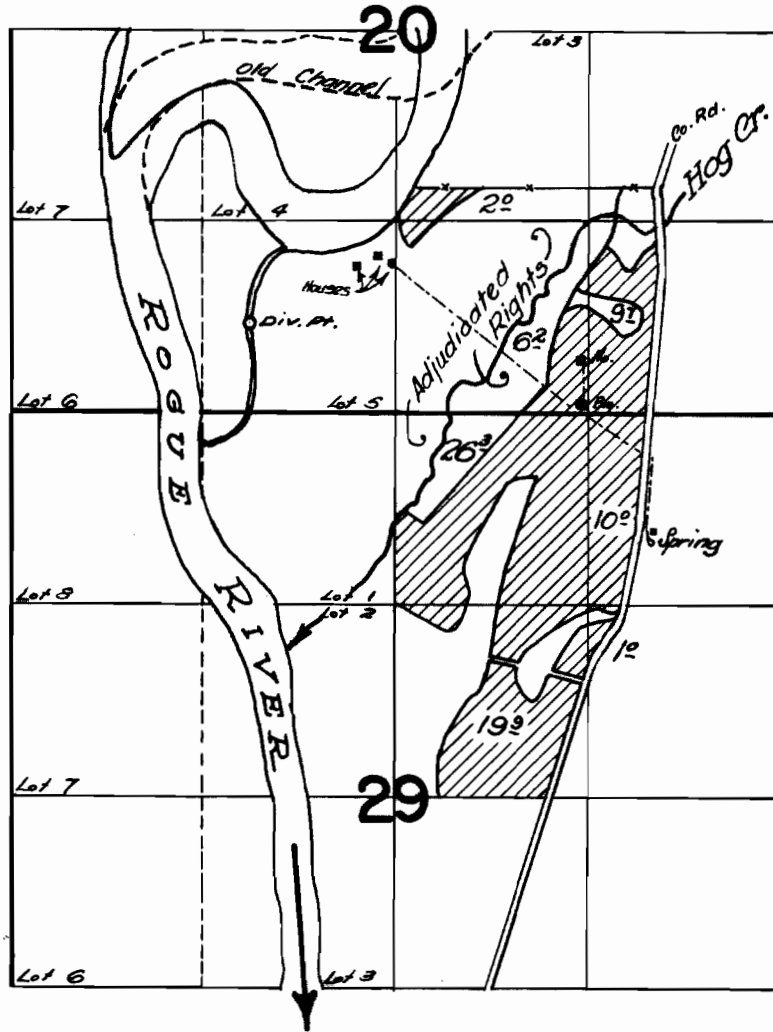

## FINAL PROOF SURVEY UNDER

Application No. 33927... Permit No. 26751...  
IN NAME OF

.....JAMES C. LUCE.....

Surveyed June 11, 1963, by C. R. Baker...