


T.36S.R.3W.W.M.

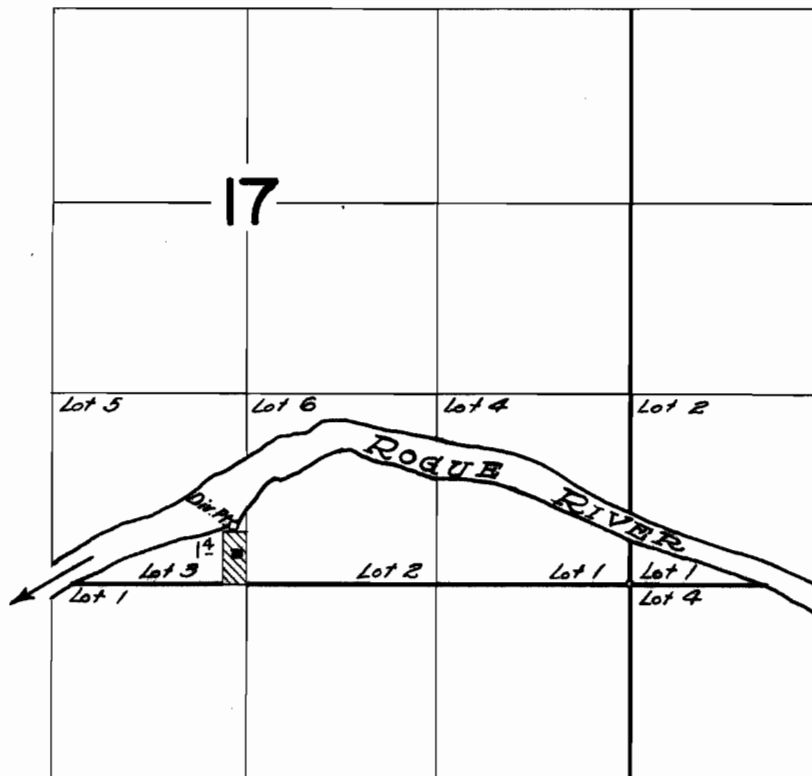

**FINAL PROOF SURVEY**  
UNDER

Application No. 37015..... Permit No. 28268...  
IN NAME OF

*AUGUST B. and VEVIAN CLARK*

Surveyed July 13, 1963, by C. R. Baker...