


T.17S. R.3W.W.M.

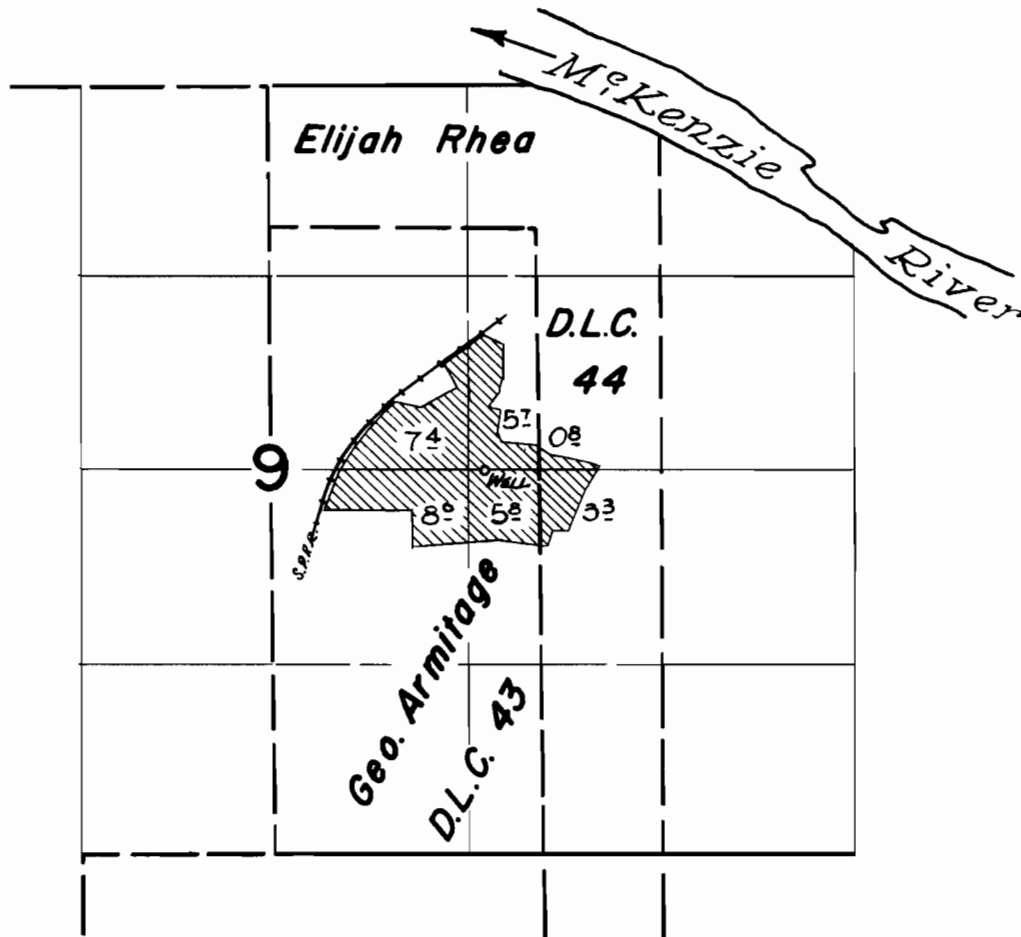

**FINAL PROOF SURVEY**  
UNDER

Application No. G-2267. Permit No. G-2102...  
IN NAME OF

.....MILTON A. CHASE.....

Surveyed May 10, 1963, by C. Baker.....