


T.20S.R.5W. W.M.

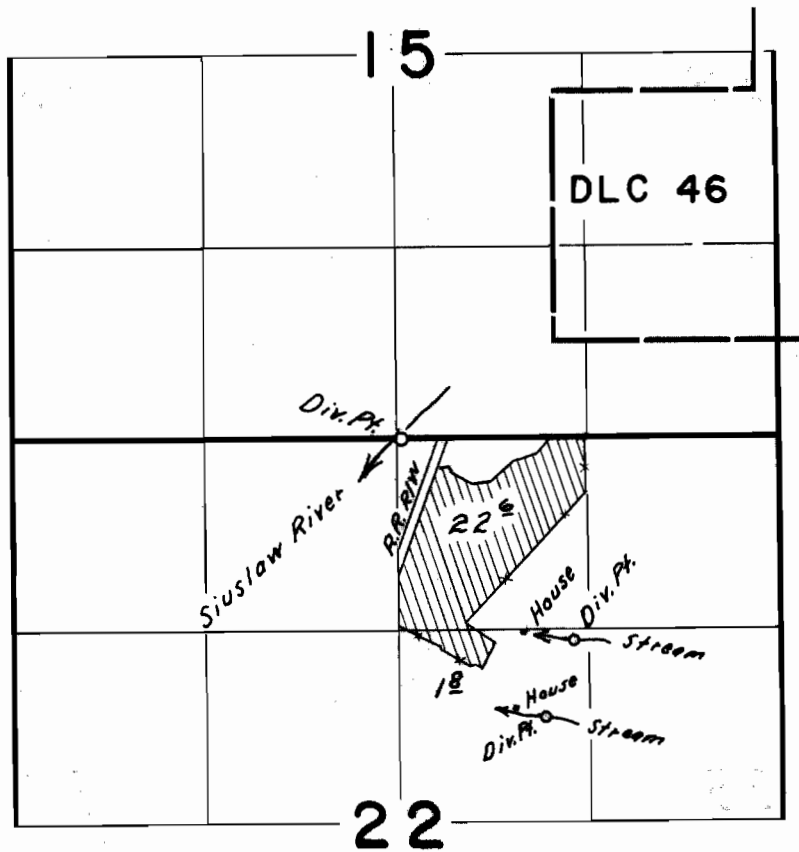

FINAL PROOF SURVEY
UNDER

Application No. 33384 Permit No. 26446
IN NAME OF

ELMER & LAVERNE BRISLER

Surveyed July 1, 1964, by R. Jackson