


T.17S.R.1W.W.M.

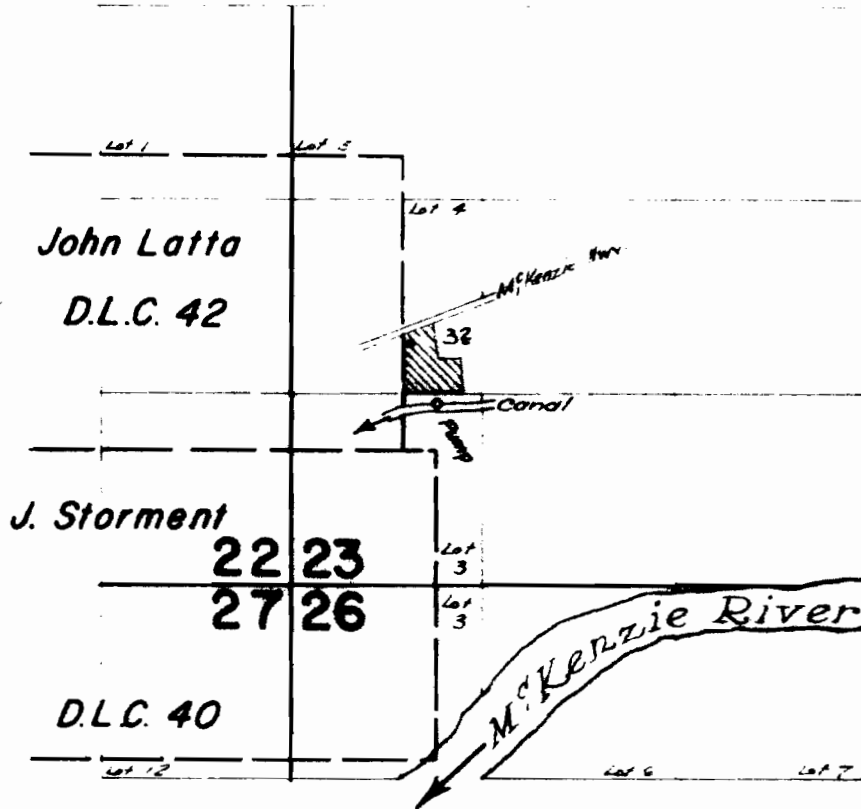

FINAL PROOF SURVEY
UNDER

Application No. 34054 . Permit No. 26847
IN NAME OF

O. C. EDDINGS

Surveyed May 8 1963, by C. Baker